

LOWNDES
 P 9004
 6-16-76

MISSISSIPPI
 BOARD OF WATER COMMISSIONERS
 416 North State Street
 Jackson, Mississippi 39201

WATER WELL DRILLERS LOG

June 16 1976 - Ahhsan Drilling Inc. Lowndes
 date well completed firm name county well located

LANDOWNER: Mr. VAY HARRIS
 Mrs. Lessie HARRIE
 Rt Box 72
 Crawford MS. 39743
 (mailing address)

description of formations encountered	from	to
Top Soil	0	15
Lime Rock	15	240
1st SAND	240	290
Mack	290	320
2nd SAND	320	450

WELL LOCATION:

sec. 19 T. 20N R. 18E
 1.5 miles S. of Columbus
 (distance) (direction) (nearest town)

WELL PURPOSE: none
 (home, irrigation, municipal, industrial)

WELL COMPLETION DATA:

- (1) diameter (inches) 4" x 2"
- (2) total depth (feet) 450'
- (3) static water level (feet) 100' below top of ground.
- (4) casing 4" plastic, 370' (material) (depth)
 4" x 2" (size) if telescope see back.
- (5) screen 80' 370' (length) (depth to top)
 4" x 2" plastic (size) (material)
- (6) pump 1/2 (HP) 9 (yield gpm)
 Electric (type power)
- (7) electric log NO (yes or no)
 (organization running log)
- (8) how well bottom plugged Cap


RECEIVED
 MAY 12 1978

MISS. BD. OF WATER COMM

DRILLERS REMARKS:

If well telescopes please sketch and show depths.

GROUND LEVEL

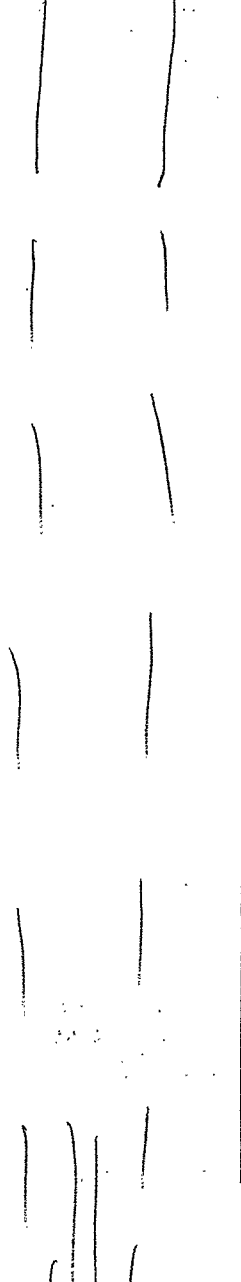


40'
4"
Casing

250'
2"
Casing

80'
C.
screen

If more than one screen, show locations of each on sketch.

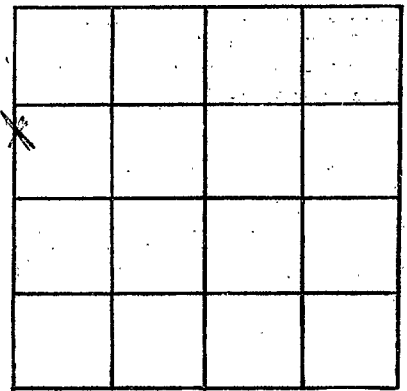

SECTION 19

Please indicate well location X.

ADDITIONAL INFORMATION

A series of horizontal lines for additional information, currently blank.