

LOWNDES
P 7007
5-2-78

MISSISSIPPI
BOARD OF WATER COMMISSIONERS
416 North State Street
Jackson, Mississippi 39201

WATER WELL DRILLERS LOG

May 2 1978 ALLsup Drilling, Inc. LOWNDES
date well completed firm name county well located

LANDOWNER: ^{MR.} George Foster, Jr.
Rt. 1, Box 54
Crawford Ms. 39443
(mailing address)

description of formations encountered,	from	to
	Top Soil	0
Lime Rock	15	240
1st SAND	240	290
Muck	290	320
2nd SAND	320	650

WELL LOCATION:
sec. 19 T. 26^N R. 18^E
10 1/2 miles S of Columbus
(distance) (direction) (nearest town)

WELL PURPOSE: home
(home, irrigation, municipal, industrial)


- WELL COMPLETION DATA:
- (1) diameter (inches) 4" x 2"
 - (2) total depth (feet) 650'
 - (3) static water level (feet) 70' ^{below} _{above} top of ground.
 - (4) casing 4" plastic, 36' (material) (depth)
4" x 2" (size) If telescope see back.
 - (5) screen 80' (length) 570' (depth to top)
4" x 2" plastic (size) (material)
 - (6) pump 1/2 (HP) 10 (yield gpm)
Electric (type power)
 - (7) electric log NO (yes or no)
(organization running log)
 - (8) how well bottom plugged CAP

DRILLERS REMARKS:

RECEIVED
DEC - 1 1978
MISS. BD. OF WATER COMMISSIONERS

If well telescopes please sketch and show depths.


GROUND LEVEL

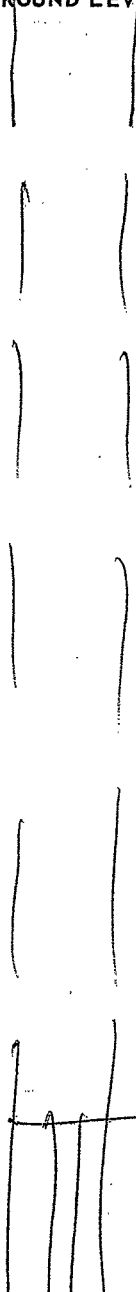

26'
4" casing

200'
2" casing

80' Connected
Screen

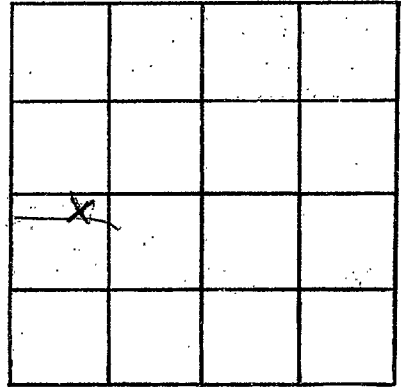

SECTION 19

Please indicate well location X.

ADDITIONAL INFORMATION

If more than one screen,
show locations of each on sketch.