

LOWNDES

P 2008
6/20/80
6-20

MISSISSIPPI
BOARD OF WATER COMMISSIONERS
416 North State Street
Jackson, Mississippi 39201

WATER WELL DRILLERS LOG

date well completed

firm name

county well located

1980 ALL SUP Drilling INC. LOWNDES

LANDOWNER: Mrs. Mary Coleman
Rt. 1, Box 177
Columbus, Ms. 39701
(mailing address)

description of formations encountered

from

to

top soil	0	15
lime rock	15	200
1st sand	200	380

WELL LOCATION:

sec 27 T 20 R 18E
13 miles S of Columbus
(distance) (direction) (nearest town)

WELL PURPOSE: none
(home, irrigation, municipal, industrial)

WELL COMPLETION DATA:

- (1) diameter (inches) 4" X 2"
- (2) total depth (feet) 380'
- (3) static water level (feet) 21' below top of ground.
- (4) casing plastic, 26'
(material) (depth)
4" X 2" if telescope see back.
(size)
- (5) screen 80', 300'
(length) (depth to top)
4" X 2", plastic
(size) (material)
- (6) pump 1/2, 9
(HP) (yield gpm)
Electric
(type power)
- (7) electric log NO
(yes or no)
(organization running log)
- (8) how well bottom plugged CAP

MISSISSIPPI DEPT. OF NATURAL RESOURCES
BUREAU OF LAND & WATER RESOURCES

AUG 11 1980

RECEIVED


DRILLERS REMARKS:

If well telescopes please sketch and show depths.


GROUND LEVEL



26'
4" casing

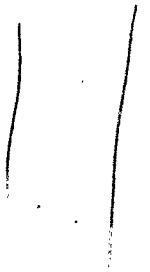

160' 2"
Casing
80' 2"
Commercial
Screen

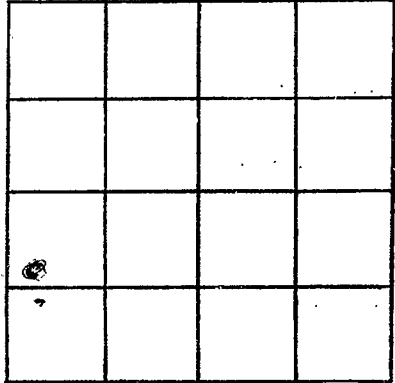

SECTION 27

Please indicate well location X.

ADDITIONAL INFORMATION

A series of horizontal lines for providing additional information.

If more than one screen, show locations of each on sketch.