

LOWNDES

P 2011

4-10-78

MISSISSIPPI
BOARD OF WATER COMMISSIONERS
416 North State Street
Jackson, Mississippi 39201

WATER WELL DRILLERS LOG

4-10

date well completed

1978 Anthony Dilly Co.

firm name

Lowndes
~~Lowndes~~

county well located

LANDOWNER:

Jim 2 Williams

Col. Miss.

(mailing address)

description of formations encountered

from

to

clay
limstone
Sand & Shale

0 5
5 100
100 340

WELL LOCATION:

sec. 28 T. 206 R. 18 E
17N 34

(distance) miles (direction) of (nearest town)

WELL PURPOSE: Home
(home, irrigation, municipal, industrial)

WELL COMPLETION DATA:

- (1) diameter (inches) 4"
- (2) total depth (feet) 340'
- (3) static water level (feet) 50 ^{below} _{above} top of ground.

(4) casing PRC 20' top
(material) (depth)

 If telescope see back.
(size)

(5) screen 200' 140
(length) (depth to top)
2" PRC
(size) (material)

(6) pump 1 6
(HP) (yield gpm)

elect
(type power)

(7) electric log no
(yes or no)

(organization running log)

(8) how well bottom plugged capped

Miss. Board of Water Comm.


DRILLERS REMARKS:

JUL 5 1978

RECEIVED

If well telescopes please sketch and show depths.

GROUND LEVEL

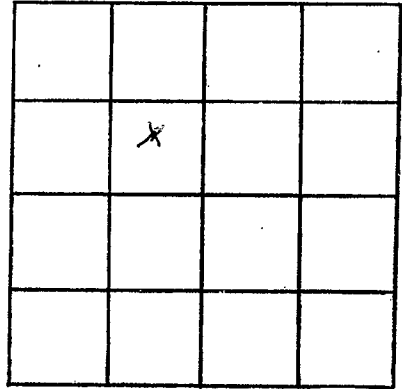

SECTION 2D

Please indicate well location X.

ADDITIONAL INFORMATION

A series of horizontal lines for writing additional information.

If more than one screen, show locations of each on sketch.