

LOWNDES
 P 9012
 4-20-78

MISSISSIPPI
 BOARD OF WATER COMMISSIONERS
 416 North State Street
 Jackson, Mississippi 39201

WATER WELL DRILLERS LOG


Apr. 20 1978 Mid South Drly. Co. Lowndes
 date well completed firm name county well located

LANDOWNER: <u>Warence Johnson</u>	description of formations encountered	from	to
(mailing address)	<u>purple clay</u>	<u>0</u>	<u>15</u>
WELL LOCATION:	<u>blue clay</u>	<u>15</u>	<u>160</u>
sec. <u>20</u> T. <u>20</u> N. R. <u>18</u> E.	<u>sand</u>	<u>160</u>	<u>235</u>
<u>12</u> miles <u>SW</u> of <u>Columbus</u>	<u>blue clay</u>	<u>235</u>	<u>247</u>
(distance) (direction) (nearest town)	<u>sand</u>	<u>247</u>	<u>255</u>
WELL PURPOSE: <u>home</u> (home, irrigation, municipal, industrial)			
WELL COMPLETION DATA:			
(1) diameter (inches) <u>4"</u>			
(2) total depth (feet) <u>255'</u>			
(3) static water level (feet) <u>45</u> ^{below} above top of ground.			
(4) casing <u>PVC</u> , <u>126'</u> (material) (depth)			
<u>0</u> if telescope see back. (size)			
(5) screen <u>none</u> , (length) (depth to top)			
(size) (material)			
(6) pump <u>V</u> <u>7</u> (HP) (yield gpm)			
<u>electric</u> (type power)			
(7) electric log <u>no</u> (yes or no)			
<u>no</u> (organization running log)			
(8) how well bottom plugged <u>open</u>			
DRILLERS REMARKS:			

RECEIVED
 AUG 10 1978
 MISS. BR. OF WATER COMM.

If well telescopes please sketch and show depths.

GROUND LEVEL

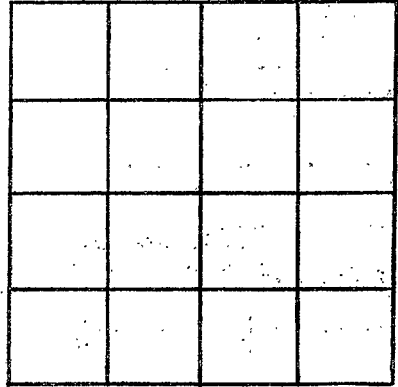

SECTION _____

Please indicate well location X.

ADDITIONAL INFORMATION

If more than one screen, show locations of each on sketch.