

MISSISSIPPI DEPARTMENT OF NATURAL RESOURCES

Bureau of Land and Water Resources

Southport Mall

P.O. Box 10631

Jackson, Mississippi 39209

WATER WELL DRILLERS LOG

Lewis
P2017

2-10
date well completed

St. Clardy Well Drilling
firm name

Lewis
county well located

LANDOWNER: John Haddaway

RA.

Stevens, Mrs.
(mailing address)

WELL LOCATION:

sec. 29 T. 30N R. 18E
11 1/2 miles 50 of Calhoun
(distance) (direction) (nearest town)

WELL PURPOSE: home
(home, irrigation, municipal, industrial)

WELL COMPLETION DATA:

- (1) diameter (inches) 4"
- (2) total depth (feet) 262'
- (3) static water level (feet) 15' below top of ground.
- (4) casing PVC 140' (material) (depth)
4" (size) if telescope see back.
- (5) screen 46" (length) 216' (depth to top)
2" (size) PVC (material)
- (6) pump 1/2 (HP) 900 (yield gpm) gph.
- elec (type power)
- (7) electric log No (yes or no)

(organization running log)

(8) how well bottom plugged

description of formations encountered	from	to
<u>brown clay</u>	<u>0</u>	<u>9</u>
<u>lime rock</u>	<u>9</u>	<u>12 1/2</u>
<u>sm. rock</u>	<u>12 1/2</u>	<u>12 1/2</u>
<u>tan clay</u>	<u>12 1/2</u>	<u>131 1/2</u>
<u>bandy clay</u>	<u>131 1/2</u>	<u>150</u>
<u>sandy clay</u>	<u>150</u>	<u>159</u>
<u>good sand</u>	<u>159</u>	<u>160</u>
<u>bandy clay</u>	<u>160</u>	<u>162</u>
<u>good sand</u>	<u>162</u>	<u>170</u>
<u>rock 6"</u>	<u>170</u>	<u>171</u>
<u>sandy good sand</u>	<u>171</u>	<u>178</u>
<u>rock 6"</u>	<u>178</u>	<u>185</u>
<u>sandy good sand</u>	<u>185</u>	<u>185 1/2</u>
<u>rock 18"</u>	<u>185 1/2</u>	<u>193</u>
<u>good sand</u>	<u>193</u>	<u>215</u>
<u>rock 18"</u>	<u>215 1/2</u>	<u>227</u>
<u>good sand</u>	<u>227</u>	<u>228</u>
<u>rock</u>	<u>228</u>	<u>240</u>
<u>bandy good sand</u>	<u>240</u>	<u>248</u>
<u>rock 6"</u>	<u>248</u>	<u>248 1/2</u>
<u>good sand</u>	<u>248 1/2</u>	<u>259</u>
<u>blue clay</u>	<u>259</u>	<u>262</u>

DEPT. OF NATURAL RESOURCES
BUREAU OF LAND & WATER RESOURCES


MAR 27 1984

RECEIVED


DRILLERS REMARKS:

If well telescopes please sketch and show depths.

GROUND LEVEL

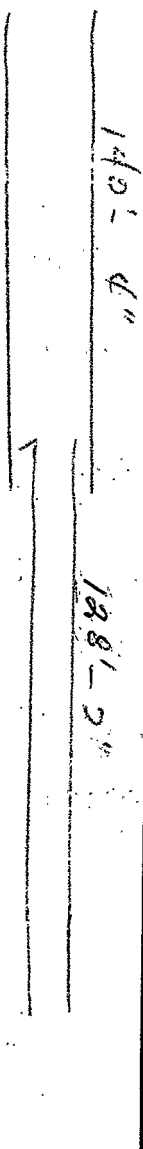

lock
11' blank
1/2 inch catch
15' blank
3/4 inch catch
1' blank
3/4 inch catch
5' blank
4/6 screen
sand short

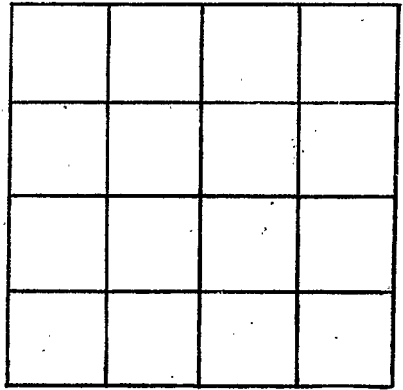

SECTION _____

Please indicate well location X.

ADDITIONAL INFORMATION

Multiple horizontal lines for additional information.

If more than one screen, show locations of each on sketch.