

**MISSISSIPPI DEPARTMENT OF NATURAL RESOURCES**  
**Bureau of Land and Water Resources**  
 Southport Mall  
 P.O. Box 10631  
 Jackson, Mississippi 39209  
**WATER WELL DRILLERS LOG**

Lowndes  
P 2018

October 23 1984 Allsup Drilling, Inc. Lowndes  
 date well completed firm name county well located

LANDOWNER: <u>Alice Wayne</u>	description of formations encountered	from	to
<u>RR 2, Box 85</u>			
<u>Prairie Pt., MS 39353</u> (mailing address)	<u>Lime Rock</u>	<u>8'</u>	<u>380'</u>
<b>WELL LOCATION:</b>	<u>1st Sand</u>	<u>380'</u>	<u>430'</u>
sec <u>29</u> T <u>20</u> R <u>18</u>	<u>Muck</u>	<u>430'</u>	<u>470'</u>
<u>10 3/4</u> miles <u>E.</u> of <u>Crawford</u>	<u>2nd Sand</u>	<u>470'</u>	<u>570'</u>
(distance) (direction) (nearest town)			
<b>WELL PURPOSE:</b> <u>Home</u> (home, irrigation, municipal, industrial)			
<b>WELL COMPLETION DATA:</b>			
(1) diameter (inches) <u>4"</u>			
(2) total depth (feet) <u>570'</u>			
(3) static water level (feet) <u>60'</u> below above top of ground.			
(4) casing <u>PVC</u> <u>20'</u> (material) (depth)			
<u>4" x 2"</u> (size) If telescope see back.			
(5) screen <u>80'</u> <u>490'</u> (length) (depth to top)			
<u>2"</u> <u>PVC</u> (size) (material)			
(6) pump <u>1/2</u> <u>7</u> (HP) (yield gpm)			
<u>Electric</u> (type power)			
(7) electric log <u>No</u> (yes or no)			
(organization running log)			
(8) how well bottom plugged			
<b>DRILLERS REMARKS:</b>			

**RECEIVED**

MAY 09 1988

Department of Natural Resources  
 Bureau of Land & Water Resources


If well telescopes please sketch and show depths.

GROUND LEVEL

26' 4" CASING

160' 2" CASING

80' 2" SCREEN

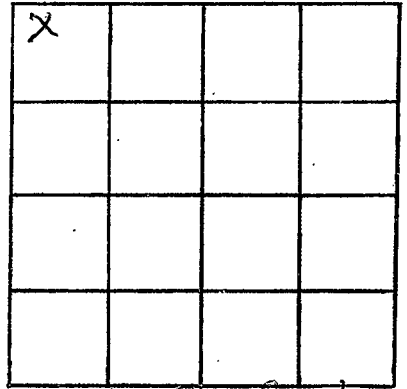

North East 1/4 of  
SECTION 29

Please indicate well location X.

ADDITIONAL INFORMATION

If more than one screen,  
show locations of each on sketch.