

MISSISSIPPI DEPARTMENT OF NATURAL RESOURCES

Bureau of Land and Water Resources

P.O. Box 10631

Jackson, Mississippi 39209

WATER WELL DRILLERS LOG

COUNTY WELL LOCATED Lauderdale	
WELL NUMBER P 2011	CODED
DATE WELL COMPLETED 5/26/89	

PERMIT NUMBER
NAME OF DRILLING FIRM Clardy Well Drill Columbus, Mo

NAME & MAILING ADDRESS OF LANDOWNER Camp Pratt (Ymca) 602 2nd Ave. N. Columbus, Mo. 39701			
WELL LOCATION: SEC	TOWNSHIP	RANGE	
15	30	N 18 E	
DISTANCE	DIRECTION	NEAREST TOWN	
9 3/4 Miles	South of	Columbus	
OTHER LANDMARK			
WELL PURPOSE: Home, Irrigation, Municipal, Industrial, Fish Pond, etc. Home			

PUMP DATA			
PUMP TYPE (Circle One): Submersible , Turbine, Jet, Flowing Well, Other (Describe) _____			
POWER TYPE (Circle One): Electric , Tractor, Diesel, Gasoline, Butane, Other (Describe) _____			
Pump Capacity (GPM)	No. of Stages	Setting Depth	
1800	12	60 FT.	
PUMP TEST			
Well yielded 1,800 GPM with a drawdown of _____ ft. after _____ hours of pumping			

WELL DATA		
Well Depth 222	Casing Diameter (In.) 4"	Casing Length (Ft.) 102'
Type of Casing PVC	Hole Depth 118	Depth to Static Water Level 11 1/2'
TYPE OF COMPLETION: (Circle One or More): Gravel Packed, Underreamed, Telescoped, Natural Development, Open Hole, Other (Describe) _____		
Top of Lap Pipe or Reduction in Casing		
FEET IF TELESCOPED OR MORE THAN ONE SCREEN: USE BACK PAGE		

LOG DATA	
TYPE OF LOG RUN (Circle One): No Log Run, Electric, Gamma Ray, Density, Sonic, Neutron, Other (Describe) _____	
Name of Organization Running Log	

GEOLOGIC DATA (Office Use Only)			
Surface Elev.	Geologic Unit	Unit Thickness	Depth to Top
Subs. SWL	Date	Analysis	Acquifer Test
	JUL 05 1989		

SCREEN DATA		
Diameter - Inches	Length - Feet	Slot Size - Inches
Screen Type		Depth to Bottom - Feet


Driller's Remarks
Department of Natural Resources Bureau of Land & Water Resources

DESCRIPTION OF FORMATIONS ENCOUNTERED	FROM	TO	FORMATIONS (Continued)	FROM	TO
Sandy clay	0	14	sand streaks	138	142
sand & peat gravel	14	20	sandy clay	142	145
sand stone	20	21	Clay	145	160
sandy clay	21	25	sandy clay	160	162
Blue clay	25	30	fine sand streak	162	172
sandy clay	30	50	Clay	172	178
Blue clay	50	74	sandy clay	178	180
sandy clay	74	87	sand strike	180	185
Blue clay	87	97	Clay	185	195
sandy clay	97	121	sandy clay	195	198
Clay	121	138			

IF MORE SPACE IS NEEDED, USE BACK

If well telescopes please sketch and show depths.

GROUND LEVEL

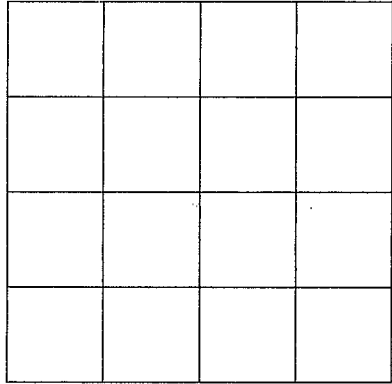

SECTION _____

Please indicate well location X.

ADDITIONAL INFORMATION

Sand. streak	198-202
Sandy clay	202-206
Small rock	206
Sandy clay	206-217
Small rock	217
Clay	217-222

If more than one screen, show location of each on sketch.