

Lowndes
 Q8
 11-68

MISSISSIPPI
 BOARD OF WATER COMMISSIONERS
 416 North State Street
 Jackson, Mississippi 39201

CODED
CODED
 CODED

WATER WELL DRILLERS LOG

11-30 1968 Clardy Well Drilling Lowndes
 date well completed film name county well located

LANDOWNERS Leo Bailey
Nashville Ferry Rd.
Columbus, Miss.
 (mailing address)

description of formations encountered	from	to
Top soil	0	10
Sand & gravel	10	40
Blue rock	40	50
Sandy Clay	50	55
rock		
Sandy Strucks & Clay	55	60
Clay	60	70
Sand	70	75
Clay	75	80
Sand	80	100
Clay	100	140
Sand	140	155

WELL LOCATION: 17
 sec. 5 T 20 N R 10 E W
 S4

_____ miles _____ of _____
 (distance) (direction) (nearest town)

WELL PURPOSE:
 (home, irrigation, municipal, industrial)

WELL COMPLETION DATA:

- (1) diameter (inches) 4"
- (2) total depth (feet) 155
- (3) static water level (feet) 3 below above top of ground.
- (4) casing Steel, 44',
 (material) (depth)
- _____ if telescope see back.
 (size)
- (5) screen _____,
 (length) (depth to top)
- _____ (size) _____ (material)
- (6) pump _____,
 (HP) (yield gpm)
- _____ (type power)
- (7) electric log _____
 (yes or no)
- _____ (organization running log)
- (8) how well bottom plugged _____

CODED


DEC 13 1968

MISS. Bd. OF
 WATER COMMISSIONERS

DRILLERS REMARKS:

If well telescopes please
sketch and show depths.

GROUND LEVEL

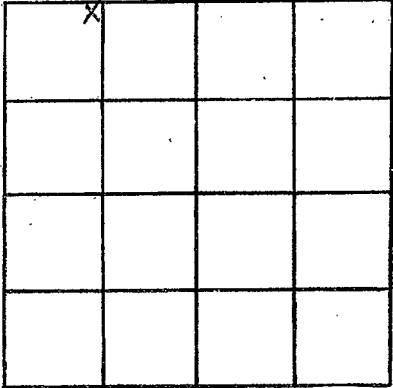

SECTION _____

Please indicate well location X.

ADDITIONAL INFORMATION

A series of horizontal lines for additional information.

If more than one screen,
show locations of each on sketch.