

**CODED**  
CODED

MISSISSIPPI  
BOARD OF WATER COMMISSIONERS  
416 North State Street  
Jackson, Mississippi 39201

**WATER WELL DRILLERS LOG**

LOWNDES  
Q9  
7-19-69

7-19-69 19 Columbus Well Drilling Lowndes  
date well completed firm name county well located

LANDOWNER: A. G. Godwin  
Highway 69  
Columbus, Miss.  
(mailing address)  
WELL LOCATION:  
sec. 3 T 20 N R 17 E  
S W  
14 miles South of Columbus  
(distance) (direction) (nearest town)

description of formations encountered	from	to
Blue clay	10	60
Sandy clay & rock	60	75
Rock	75	77
Sandy streaks	77	100
Blue clay	100	120
Sand & rock	120	130
Blue clay	130	135
Sandy streaks	135	145
Blue clay	145	185
Sandy streaks	185	195
Blue clay	195	200
Sandy streaks	200	220
Blue clay	220	225

WELL PURPOSE: home  
(home, irrigation, municipal, industrial)

- WELL COMPLETION DATA:
- (1) diameter (inches) 4"
  - (2) total depth (feet) 225
  - (3) static water level (feet) 5 1-19-72 12.8 below above top of ground.
  - (4) casing Steel 55'  
(material) (depth)  
(size) if telescope see back.
  - (5) screen None  
(length) (depth to top)  
(size) (material)
  - (6) pump None  
(HP) (yield gpm)  
(type power)
  - (7) electric log No  
(yes or no)  
(organization running log)
  - (8) how well bottom plugged Open

**CODED**


SEP 2 1969

MISS. DEPT. OF WATER RESOURCES

DRILLERS REMARKS:

If well telescopes please sketch and show depths.

GROUND LEVEL

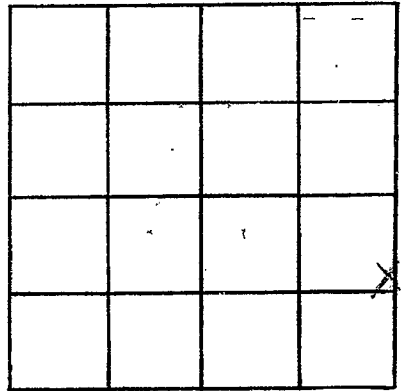

SECTION \_\_\_\_\_

Please indicate well location X.

ADDITIONAL INFORMATION

If more than one screen,  
show locations of each on sketch.