

LOWNDES

Q 2003

4-28-78

MISSISSIPPI
 BOARD OF WATER COMMISSIONERS
 416 North State Street
 Jackson, Mississippi 39201

WATER WELL DRILLERS LOG

April 28 19 78 Mid South Drig. co. Lowndes
 date well completed firm name county well located

LANDOWNER: Mr. Joe Abarms	description of formations encountered	from	to
Hwy. 69 South			
Columbus, Miss 39701 (mailing address)	sand	225	235
	clay	235	285
	sand & gravel	285	320
WELL LOCATION:			
sec. 3 T. 20 N R. 10 E			
10 miles S.E. of Columbus			
(distance) (direction) (nearest town)			
WELL PURPOSE: home (home, irrigation, municipal, industrial)			
WELL COMPLETION DATA:			
(1) diameter (inches) 4"			
(2) total depth (feet) 320'			
(3) static water level (feet) 7' below above top of ground.			
(4) casing PVC 90' (material) (depth)			
4" If telescope see back. (size)			
(5) screen none (length) (depth to top)			
(size) (material)			
(6) pump 1/2 jet 7 (HP) (yield gpm)			
electric (type power)			
(7) electric log no (yes or no)			
(organization running log) none			
(8) how well bottom plugged open			
DRILLERS REMARKS:			


RECEIVED

MAY 15 1978

MISS. Bd. OF WATER COM.

If well telescopes please sketch and show depths.

GROUND LEVEL

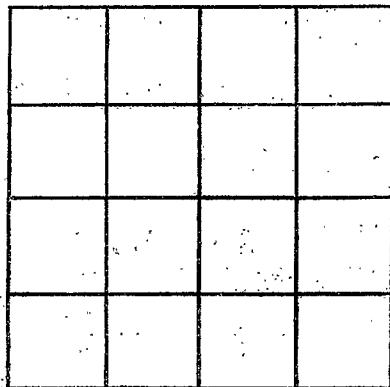

SECTION _____

Please indicate well location X

ADDITIONAL INFORMATION

If more than one screen,
show locations of each on sketch.