

LOWNDES
 QMS

MISSISSIPPI
 BOARD OF WATER COMMISSIONERS
 416 North State Street
 Jackson, Mississippi 39201

WATER WELL DRILLERS LOG

8-1 1979 Mid South Drilling Co. Lumberton
 date well completed firm name county well located

LANDOWNER: <u>Wardell Anthony</u>	description of formations encountered	from	to
<u>Columbus, MS 39702</u> (mailing address)	clay	0	165
	clay + sand	165	195
	sand	195	240
	clay + sand	240	555

WELL LOCATION:

sec 13 T 20 R 18E
 S 10 miles N of W. Col.
 (distance) (direction) (nearest town)

WELL-PURPOSE: Home
 (home, irrigation, municipal, industrial)

WELL COMPLETION DATA:

- (1) diameter (inches) 4
- (2) total depth (feet) 585
- (3) static water level (feet) 50 below top of ground.
- (4) casing PVC, 150
 (material) (depth)
4 if telescope see back.
 (size)
- (5) screen AD, 5
 (length) (depth to top)
 (size) (material)
- (6) pump 3/4 10
 (HP) (yield gpm)
electric
 (type power)
- (7) electric log no
 (yes or no)
no
 (organization running log)
- (8) how well bottom plugged Open

Miss. Board of Water Comm.


AUG 27 1979

DRILLERS REMARKS:

RECEIVED

If well telescopes please sketch and show depths.

GROUND LEVEL

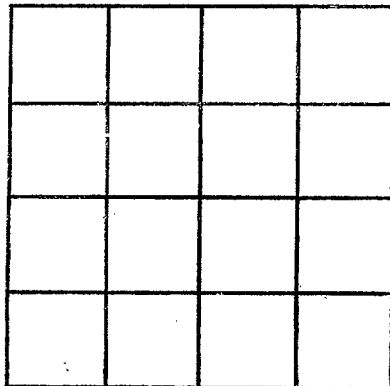

SECTION _____

Please indicate well location X.

ADDITIONAL INFORMATION

If more than one screen, show locations of each on sketch.