

MISSISSIPPI DEPARTMENT OF NATURAL RESOURCES

Bureau of Land and Water Resources

Southport Mall

P.O. Box 10631

Jackson, Mississippi 39209

WATER WELL DRILLERS LOG

LOWNDES
Q 9008
11-25-80

11-25 date well completed

Clardy Well Drilling firm name

Lowndes county well located

LANDOWNER: George Cain
 1305 Beverly Lane
 Columbus, Miss.
 (mailing address)

WELL LOCATION:
 sec. 17 T-820 N R-117 W
 12 miles SE of Hols.
 (distance) (direction) (nearest town)

WELL PURPOSE: Camp houses
 (home, irrigation, municipal, industrial)

- WELL COMPLETION DATA:**
- (1) diameter (inches) 4"
 - (2) total depth (feet) 131'
 - (3) static water level (feet) 5 below top of ground.
 - (4) casing PVC 63'-8"
 (material) (depth)
 (size) if telescope see back.
 - (5) screen _____
 (length) (depth to top)
 (size) (material)
 - (6) pump 1/2 900 gph.
 (HP) (yield gph)
Elec.
 (type power)
 - (7) electric log no
 (yes or no)
 (organization running log)
 - (8) how well bottom plugged _____

| description of formations encountered | from | to |
|---------------------------------------|------|-----|
| Gravel | 12 | 36 |
| Clay | 36 | 89 |
| Sandy clay | 89 | 95 |
| Sand | 95 | 96 |
| Clay | 96 | 98 |
| Sand | 98 | 109 |
| Clay | 109 | 114 |
| Rock | 114 | 118 |
| Clay | 118 | 121 |
| Rock | 121 | 126 |
| Clay | 126 | 129 |
| Rock | 129 | 131 |
| Clay | 129 | 131 |
| | | |
| | | |
DEPT. OF NATURAL RESOURCES
 BUREAU OF LAND & WATER RESOURCES


DEC 8 1980

RECEIVED

DRILLERS REMARKS: _____

If well telescopes please
sketch and show depths.

GROUND LEVEL

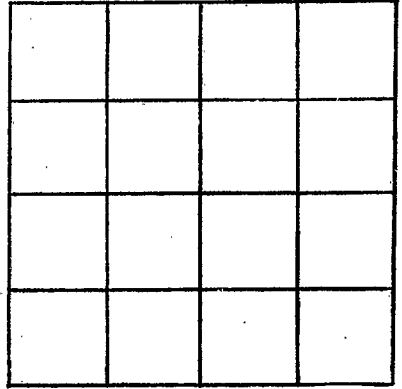

SECTION _____

Please indicate well location X.

ADDITIONAL INFORMATION

If more than one screen,
show locations of each on sketch.