

MISSISSIPPI DEPARTMENT OF NATURAL RESOURCES

Bureau of Land and Water Resources

Southport Mall

P.O. Box 10631

Jackson, Mississippi 39209

WATER WELL DRILLERS LOG

LOWNDES
 Q 2009
 11-20-80

11-20 1980 Chardy Well Drilling Lowndes
 date well completed firm name county well located

LANDOWNER: Charles Finch
105 Dellwood Dr.
Columbus, Miss.
 (mailing address)

WELL LOCATION: 17 19W
 sec. 17 T. 18 N. R. 19W
12 miles SE of Colo.
 (distance) (direction) (nearest town)

WELL PURPOSE: camp house
 (home, irrigation, municipal, industrial)

WELL COMPLETION DATA:

(1) diameter (inches) 4"

(2) total depth (feet) 122.1

(3) static water level (feet) 5 below above top of ground.

(4) casing PVC 5.8'
 (material) (depth)
 (size) if telescope see back.

(5) screen _____
 (length) (depth to top)
 (size) (material)

(6) pump 900 gph
 (HP) (yield gpm)
Elec.
 (type power)

(7) electric log no
 (yes or no)
 (organization running log)

(8) how well bottom plugged _____

description of formations encountered	from	to
Sand & gravel	10	34
Clay	34	39
Rock	39	
Sandy Clay	39	103
Sand	103	117
rock	117	119
Clay	122	

DEPT. OF NATURAL RESOURCES
 BUREAU OF LAND & WATER RESOURCES


DEC 8 1980

RECEIVED

DRILLERS REMARKS:

If well telescopes please sketch and show depths.

GROUND LEVEL

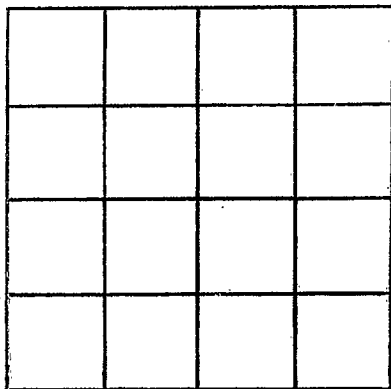

SECTION _____

Please indicate well location X.

ADDITIONAL INFORMATION

If more than one screen, show locations of each on sketch.