

MISSISSIPPI DEPARTMENT OF NATURAL RESOURCES

Bureau of Land and Water Resources

Southport Mall

P.O. Box 10631

Jackson, Mississippi 39209

WATER WELL DRILLERS LOG

LOWNDES
Q 201D
11-13-80

11/13 1980 Clardy Well Drilling Lowndes
 date well completed firm name county well located

LANDOWNER:	description of formations encountered	from	to
Barbara Jean Johnson Columbus, Miss (mailing address)			
WELL LOCATION:	Sand & gravel	16	30
sec. <u>3</u> T <u>20</u> N <u>17</u> R <u>4</u> E <u>19</u> W	Blue Clay	30	68
<u>11</u> miles <u>SE</u> of <u>Colo.</u>	Sand	68	70
(distance) (direction) (nearest town)	Clay	70	73
WELL PURPOSE: <u>home</u>	Sand	73	74
(home, irrigation, municipal, industrial)	Clay	74	76
WELL COMPLETION DATA:	Sand	76	82
(1) diameter (inches) <u>4"</u>	Clay	82	90
(2) total depth (feet) <u>112'</u>	Sand	90	91
(3) static water level (feet) <u>flowing below</u>	Clay	91	94
(4) casing <u>PVC</u> , <u>58'</u>	Sand	94	96
(material) (depth)	Clay	96	98
(size) if telescope see back.	Sand	98	104
(5) screen _____	Clay	104	110
(length) (depth to top)	Sand	110	112
(size) (material)			
(6) pump <u>1/2</u> <u>900 gpk</u>			
(HP) (yield-gpm)			
<u>Elec.</u>			
(type power)			
(7) electric log <u>no</u>			
(yes or no)			
(organization running log)			
(8) how well bottom plugged _____			
DRILLERS REMARKS:			


DEPT. OF NATURAL RESOURCES
BUREAU OF LAND & WATER RESOURCES

DEC - 8 1980

RECEIVED

If well telescopes please
sketch and show depths.

GROUND LEVEL

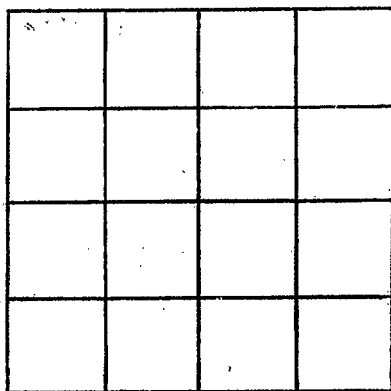

SECTION _____

Please indicate well location X.

ADDITIONAL INFORMATION

If more than one screen,
show locations of each on sketch.