

MISSISSIPPI DEPARTMENT OF NATURAL RESOURCES
Bureau of Land and Water Resources
 Southport Mall
 P.O. Box 10631
 Jackson, Mississippi 39209
WATER WELL DRILLERS LOG

Lowndes
Q 2012
4-25-81

4-25 1981 Clardy Well Drilling Lowndes
 date well completed (firm name) County well located

LANDOWNER:
Truman Aldridge
Columbus, Miss.
 (mailing address)

description of formations encountered	from	to
	<u>Sandy</u>	<u>0</u>
<u>Blu. Clay</u>	<u>18</u>	<u>57 1/2</u>
<u>Sand</u>	<u>57 1/2</u>	<u>58</u>
<u>Clay</u>	<u>58</u>	<u>59</u>
<u>Sand</u>	<u>59</u>	<u>66</u>
<u>Clay</u>	<u>66</u>	<u>70</u>
<u>Sand</u>	<u>70</u>	<u>76</u>
<u>Clay</u>	<u>76</u>	<u>78</u>
<u>Sand</u>	<u>78</u>	<u>80</u>
<u>Clay</u>	<u>80</u>	<u>117</u>
<u>sandy</u>	<u>117</u>	<u>120</u>
<u>Clay</u>	<u>120</u>	<u>142</u>
<u>Sand</u>	<u>142</u>	<u>155</u>

WELL LOCATION:
 sec. 17 T. 20 N. R. 19 E.
13 miles SE of Col.
 (distance) (direction) (nearest town)

WELL PURPOSE: Comp. house
 (home, irrigation, municipal, industrial)

- WELL COMPLETION DATA:**
- diameter (inches) 4"
 - total depth (feet) 155'
 - static water level (feet) 12' below above top of ground.
 - casing PVC, 54'
 (material) (depth)
 (size) if telescope see back.
 - screen _____
 (length) (depth to top)
 (size) (material)
 - pump 1/2 800 gpd
 (HP) (yield gpd)
 (type power)
 - electric log _____
 (yes or no)
 (organization running log)
 - how well bottom plugged Open

DRILLERS REMARKS:


DEPT. OF NATURAL RESOURCES
 BUREAU OF LAND & WATER RESOURCES

MAY 12 1981

RECEIVED

If well telescopes please sketch and show depths.

GROUND LEVEL

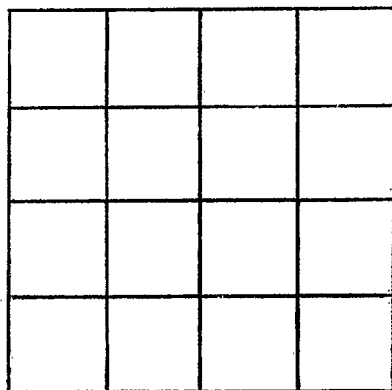

SECTION _____

Please indicate well location X.

ADDITIONAL INFORMATION

If more than one screen,
show locations of each on sketch.