

MISSISSIPPI DEPARTMENT OF NATURAL RESOURCES

Bureau of Land and Water Resources

Southport Mall

P.O. Box 10631

Jackson, Mississippi 39209

WATER WELL DRILLERS LOG

Lowndes
Q 2013

3-24-82 date well completed Clarity Well Drilling firm name Lowndes county well located

LANDOWNER: T.R. Sneed
Construction Co.
1402 11th Ave. No.
Columbus, Ms.
(mailing address)

WELL LOCATION:
sec. 16 T 20 N R. 19 E
12 miles SE of Colo.
(distance) (direction) (nearest town)

WELL PURPOSE: Home
(home, irrigation, municipal, industrial)

WELL COMPLETION DATA:

- (1) diameter (inches) 4"
- (2) total depth (feet) 182'
- (3) static water level (feet) 8' ^{below} top of ground.
- (4) casing PVC 64 1/2'
(material) (depth)
 If telescope see back.
(size)
- (5) screen
(length) (depth to top)
 (size) (material)
- (6) pump 1/2 900 gph
(HP) (yield gpm)
- (type power)
- (7) electric log (yes or no)
 (organization running log)
- (8) how well bottom plugged

description of formations encountered	from	to
<u>sand & gravel</u>	<u>0</u>	<u>42</u>
<u>rocky blue clay</u>	<u>42</u>	<u>62 1/2</u>
<u>good blue clay</u>	<u>62 1/2</u>	<u>64 1/2</u>
<u>hardy blue clay</u>	<u>64 1/2</u>	<u>75</u>
<u>blue clay</u>	<u>75</u>	<u>80</u>
<u>sand</u>	<u>80</u>	<u>99</u>
<u>clay</u>	<u>99</u>	<u>101</u>
<u>strata of sand & clay</u>	<u>101</u>	<u>182</u>

DRILLERS REMARKS:


DEPT. OF NATURAL RESOURCES
BUREAU OF LAND & WATER RESOURCES

APR 30 1982

RECEIVED

If well telescopes please sketch and show depths.

GROUND LEVEL

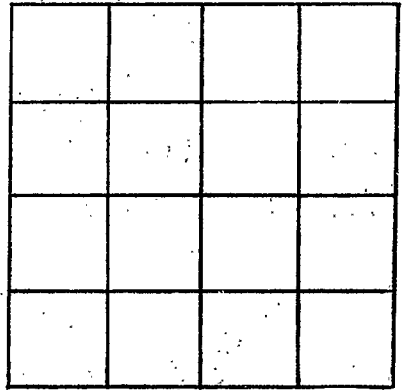

SECTION _____

Please indicate well location X.

ADDITIONAL INFORMATION

If more than one screen,
show locations of each on sketch.