

Lowndes
Q 214

MISSISSIPPI DEPARTMENT OF NATURAL RESOURCES

Bureau of Land and Water Resources

Southport Mall

P.O. Box 10631

Jackson, Mississippi 39209

WATER WELL DRILLERS LOG

6-18
date well completed

1982 Clardy Well Drilling Lowndes
firm name county well located

LANDOWNER: Best Chain
319 Lakeshore Dr
Columbus Ms.
(mailing address)

WELL LOCATION:
sec. 16 T. 30 N. R. 17 E.
12 miles SE of Colo.
(distance) (direction) (nearest town)

WELL PURPOSE: Home
(home, irrigation, municipal, industrial)

WELL COMPLETION DATA:

- (1) diameter (inches) 4"
- (2) total depth (feet) 132
- (3) static water level (feet) 8' below above top of ground.
- (4) casing PVC, 67' (material) (depth)
 if telescope see back.
(size)
- (5) screen (length) (depth to top)
(size) (material)
- (6) pump 1/2 900 gpm (HP) (yield gpm)
elec (type power)
- (7) electric log no (yes or no)
 (organization running log)
- (8) how well bottom plugged

description of formations encountered	from	to
red clay	0	8
sand & gravel	8	24
good clay	44	49
sandy clay	49	51
fair clay	51	55
good clay	55	57
sandy clay	57	65
good clay	65	78
sand	78	112
clay	79 1/2	86
sand	86	116
blue clay	116	132

DEPT. OF NATURAL RESOURCES
BUREAU OF LAND & WATER RESOURCES


JUL - 7 1982

RECEIVED

DRILLERS REMARKS:

If well telescopes please sketch and show depths.

GROUND LEVEL

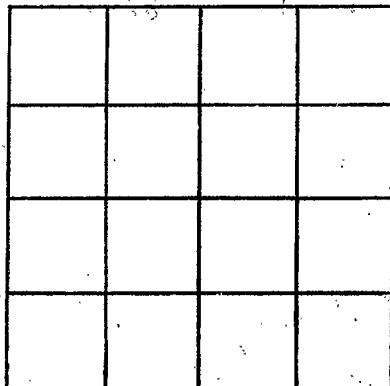

SECTION _____

Please indicate well location X.

ADDITIONAL INFORMATION

If more than one screen,
show locations of each on sketch.