

MISSISSIPPI DEPARTMENT OF NATURAL RESOURCES
Bureau of Land and Water Resources
 Southport Mall
 P.O. Box 10631
 Jackson, Mississippi 39209
WATER WELL DRILLERS LOG

Lowndes
Q 7116

8-9 date well completed 88 Hardy Well Drilling Lowndes firm name county well located

LANDOWNER: E. C. Fellows
Rt 10 Box 307
Colv, MS.
 (mailing address)

WELL LOCATION:
 sec. 16 T 20 N R. 17 E
14 miles SE of Colv.
 (distance) (direction) (nearest town)

WELL PURPOSE: Home
 (home, irrigation, municipal, industrial)

WELL COMPLETION DATA:

(1) diameter (inches) 4"

(2) total depth (feet) 126'

(3) static water level (feet) 12' below above top of ground.

(4) casing PVC, 66'
 (material) (depth)
 _____ if telescope see back.
 (size)

(5) screen _____
 (length) (depth to top)

 (size) (material)

(6) pump 1/2 900 gph.
 (HP) (yield gpm)
elec.
 (type power)

(7) electric log no
 (yes or no)

 (organization running log)

(8) how well bottom plugged _____


description of formations encountered	from	to
red clay	0	12
sand & gravel	12	31
blue clay	31	44
sandy clay	44	47
good blue clay	47	56
rocks	56	56 1/2
good blue clay	56 1/2	66
sandy clay	66	71
blue clay	71	74
sandy clay	74	80
hard clay	80	91
sand	91	126
blue clay	126	

DRILLERS REMARKS:

DEPT. OF NATURAL RESOURCES
 BUREAU OF LAND & WATER RESOURCES
 SEP 30 1993
RECEIVED

If well telescopes please sketch and show depths.

GROUND LEVEL

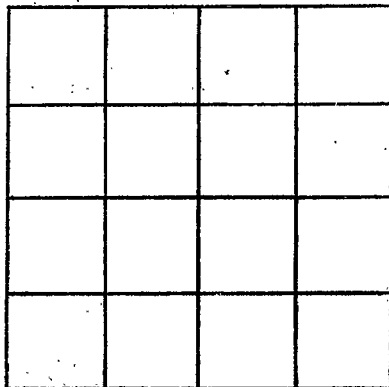

SECTION _____

Please indicate well location X.

ADDITIONAL INFORMATION

If more than one screen,
show locations of each on sketch.