

MISSISSIPPI DEPARTMENT OF NATURAL RESOURCES
Bureau of Land and Water Resources
Southport Mall
P.O. Box 10631
Jackson, Mississippi 39209
WATER WELL DRILLERS LOG

Lowndes

Q 2017

6-7-85

6-7-85
date well completed

Clardy Well Drilling Lowndes
firm name

county well located

LANDOWNER:

Description of formations encountered

from

to

Joe.ritchard
Lake Lowndes Rd.
Columbus, Ms.
(mailing address)

Sand & gravel	22	39
Sandy silty clay	39	45
clay	45	49 1/2
Dam rock		
clay	49 1/2	52 1/2
Sandy clay	52 1/2	70
sandy streaks	70	88
clay	88	97
sandy streaks	97	111 1/2
sm. rock		
sandy streaks	111 1/2	120
clay	120	124
sandy clay	124	125 1/2
sm. rock		
sandy clay	125 1/2	129 1/2
clay		
sm. rock	129 1/2	131 1/2
clay		
sm. rock	131 1/2	136
clay		
sm. rock	136	146
sm. rock		
sand	146	151 1/2
sm. rock		
sandy clay	151 1/2	159
sand	159	162
sandy streaks	162	170
clay	170	176
sandy clay	176	179
sandy streaks	179	192
good sand	192	196
sandy streaks	196	198
brown sandy clay	198	210
sandy silty clay	210	222
hard silty clay	222	252
sand, streaks	252	257 1/2
sand		
sandy streak	257 1/2	260
sand		
sandy clay	260	268
sand		
sandy clay	268	276
sandy clay		
sandy clay	276	280

WELL LOCATION:

sec. 16 T20 N R 19 E
12 miles SE of Colo.
(distance) (direction) (nearest town)

WELL PURPOSE: home
(home, irrigation, municipal, industrial)


WELL COMPLETION DATA:

- diameter (inches) 4"
- total depth (feet) 290'
- static water level (feet) overflow below/above top of ground.
- casing PVC 60' (material) (depth)
4" (size) if telescope see back.
- screen (length) (depth to top)
(size) (material)
- pump 1/2 (HP) 900 gpm (yield) etc. (type power)
- electric log no (yes or no)
RECEIVED
(organization running log)
- how well bottom plugged AUG 2 1985

DRILLERS REMARKS:
Department of Natural Resources
Bureau of Land & Water Resources

If well telescopes please sketch and show depths.

GROUND LEVEL

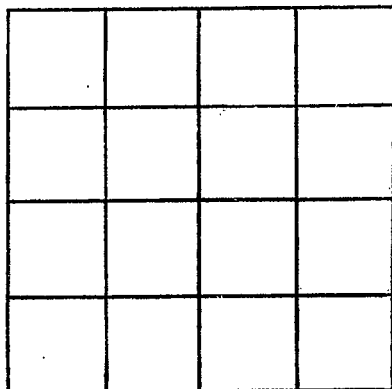

SECTION _____

Please indicate well location X.

ADDITIONAL INFORMATION

Sand 250-255'
Clay 255'-260'

If more than one screen, show locations of each on sketch.