

**MISSISSIPPI DEPARTMENT OF NATURAL RESOURCES**  
**Bureau of Land and Water Resources**  
 Southport Mall  
 P.O. Box 10631  
 Jackson, Mississippi 39209  
**WATER WELL DRILLERS LOG**

Lowndes  
 Q  
 2018

3-28-86      19 Mid. South Drilling Company      Lowndes  
 date well completed      firm name      county well located

LANDOWNER: <u>Burt Chain</u> (O.C. Electric) <u>2002 4th Ave. North</u> <u>Columbus, MS 39701</u>  (mailing address)	description of formations encountered	from	to
	clay	0	5
	sand and gravel	5	32
	clay	32	95
<b>WELL LOCATION:</b> sec. <u>17</u> T <u>20</u> <del>XX</del> R <u>10</u> <del>5</del> S	sand	95	115
<u>10</u> miles <u>South</u> of <u>Columbus</u> (distance) (direction) (nearest town)	clay	115	118
	clay and sand	118	195
	sand	195	225
	clay and sand	225	255
<b>WELL PURPOSE:</b> <u>home</u> (home, irrigation, municipal, industrial)			
<b>WELL COMPLETION DATA:</b>			
(1) diameter (inches) <u>4</u>			
(2) total depth (feet) <u>255</u>			
(3) static water level (feet) <u>45</u> below top of ground. <del>xxxxxxx</del>			
(4) casing <u>PVC</u> ( <u>115'</u> depth), <u>4"</u> (size) if telescope see back.			
(5) screen <u>none</u> (length) (depth to top) (size) (material)			
(6) pump <u>none</u> (HP) (yield gpm) (type power)			
(7) electric log <u>no</u> (yes or no) <u>no</u> (organization running log)			
(8) how well bottom plugged <u>open</u>			

**DRILLERS REMARKS:**

---



---




---

**RECEIVED**  
 APR 9 9 1986  
 Department of Natural Resources  
 Bureau of Land & Water Resources

If well telescopes please sketch and show depths.

GROUND LEVEL

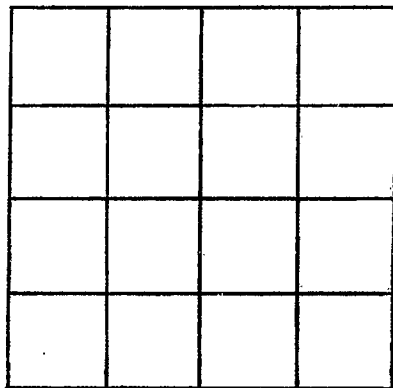

SECTION \_\_\_\_\_

Please indicate well location X.

ADDITIONAL INFORMATION

If more than one screen,  
show locations of each on sketch.