

MISSISSIPPI DEPARTMENT OF NATURAL RESOURCES

Bureau of Land and Water Resources

Southport Mall

P.O. Box 10631

Jackson, Mississippi 39209

WATER WELL DRILLERS LOG

LOWNOS
9
2019

4/24/86 19 Clardy Well Drilling Louisa
 date well completed firm name county well located


LANDOWNER: Richard Bryant
P.O. Box 2035
Columbus, Miss.
 (mailing address)

WELL LOCATION:
 sec. 17 T. 20 N. R. 19 E.
12 miles SE of Colv.
 (distance) (direction) (nearest town)

WELL PURPOSE: home
 (home, irrigation, municipal, industrial)

- WELL COMPLETION DATA:
- (1) diameter (inches) 4"
 - (2) total depth (feet) 134
 - (3) static water level (feet) 14' below above-top of ground.
 - (4) casing Pvc 60
 (material) (depth)
4"
 (size) if telescope see back.
 - (5) screen _____
 (length) (depth to top)
 (size) (material)
 - (6) pump 1/2 900 gph
 (HP) (yield-gpm)
elec
 (type power)
 - (7) electric log no
 (yes or no)
 (organization running log)
 - (8) how well bottom plugged _____

description of formations encountered	from	to
sandy clay	0	6
sand	6	12
gravel	12	22
clay	22	53
good clay	53	61 1/2
sandy clay	61 1/2	73
rock	73	
clay	73	104 1/2
sand	104 1/2	105
sandy clay	107	118
sandy silt	118	124 1/2
sandy clay	124 1/2	130
sand	130	132
clay	132	134

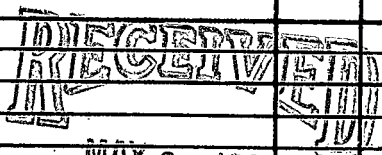


MAY 22 1986

Department of Natural Resources
 Bureau of Land & Water Resources

DRILLERS REMARKS:

If well telescopes please
sketch and show depths.

GROUND LEVEL

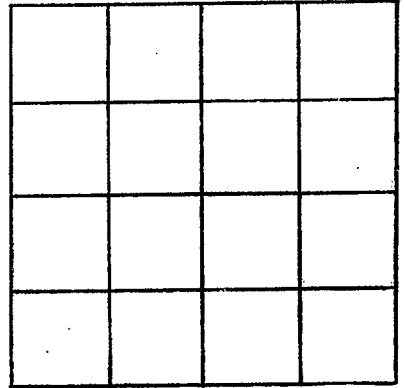

SECTION _____

Please indicate well location X.

ADDITIONAL INFORMATION

If more than one screen,
show locations of each on sketch.