

MISSISSIPPI DEPARTMENT OF NATURAL RESOURCES
Bureau of Land and Water Resources
 Southport Mall
 P.O. Box 10631
 Jackson, Mississippi 39209
WATER WELL DRILLERS LOG

LOWNDES
Q 2023

3-11-87 19 Mid South Drilling Company Lowndes
 date well completed firm name county well located

LANDOWNER: J. C. Chain
 Contractor: O.C. Electric
 2002 4th Ave. North
 Columbus, MS 39701
 (mailing address)

WELL LOCATION:
 sec. 17 T 20 N R 17 W S
 11 miles SSE of Columbus
 (distance) (direction) (nearest town)

WELL PURPOSE: home
 (home, irrigation, municipal, industrial)

- WELL COMPLETION DATA:**
- (1) diameter (inches) 4"
 - (2) total depth (feet) 240'
 - (3) static water level (feet) flowing below top of ground.
 - (4) casing PVC 125
 (material) (depth)
4" if telescope see back.
 (size)
 - (5) screen none
 (length) (depth to top)
 (size) (material)
 - (6) pump none
 (HP) (yield gpm)
 (type power)
 - (7) electric log no
 (yes or no)
none
 (organization running log)
 - (8) how well bottom plugged open

description of fomations encountered	from	to
clay	0	4
sand	4	15
sand & gravel	15	35
clay	35	37
sand	37	40
clay	40	53
sand	53	88
clay	88	101
sand with clay streaks	101	115
clay	115	116
sand	116	119
clay	119	121
sand with clay streaks	121	135
clay	135	140
sand	140	149
clay	149	160
sand	160	164
clay with sand streaks	164	176
sand	176	180
clay with sand streaks	180	189
sand with clay streaks	189	205
clay	205	212
sand	212	216
clay	216	227
sand	227-	240

RECEIVED


MAR 20 1987

Department of Natural Resources
 Bureau of Land & Water Resources

DRILLERS REMARKS:

If well telescopes please
sketch and show depths.

GROUND LEVEL

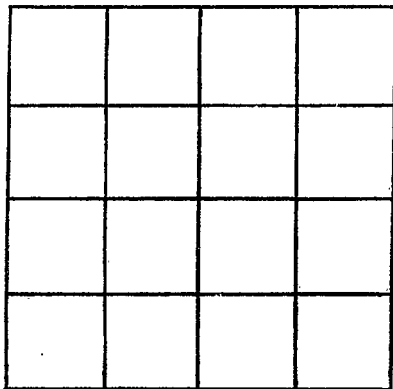

SECTION _____

Please indicate well location X.

ADDITIONAL INFORMATION

If more than one screen,
show locations of each on sketch.