

MISSISSIPPI DEPARTMENT OF NATURAL RESOURCES
Bureau of Land and Water Resources

P.O. Box 10631
Jackson, Mississippi 39209
WATER WELL DRILLERS LOG

COUNTY WELL LOCATED <i>Bondre</i>	
WELL NUMBER <i>97024</i>	CODED
DATE WELL COMPLETED <i>4/21/87</i>	

PERMIT NUMBER
NAME OF DRILLING FIRM <i>Clardy Well Drill</i> <i>501 W. 3rd Path Rd.</i>

NAME & MAILING ADDRESS OF LANDOWNER <i>R. M. Redwood</i> <i>1209 N. 7th St.</i> <i>Columbus, Mo. 39701</i>		
WELL LOCATION: SEC	TOWNSHIP	RANGE
<i>18</i>	<i>20 N</i>	<i>19 E</i>
DISTANCE <i>8 1/2</i> Miles	DIRECTION <i>South of</i>	NEAREST TOWN <i>Columbus</i>
OTHER LANDMARK		
WELL PURPOSE: Home, Irrigation, Municipal, Industrial, Fish Pond, etc.		

PUMP DATA		
PUMP TYPE (Circle One): <input checked="" type="radio"/> Submersible, Turbine, Jet, Flowing Well, Other (Describe) _____		
POWER TYPE (Circle One): <input checked="" type="radio"/> Electric, Tractor, Diesel, Gasoline, Butane, Other (Describe) _____		
Pump Capacity (GPM) <i>900</i>	No. of Stages <i>10</i>	Setting Depth <i>80</i> FT.
PUMP TEST Well yielded <i>900</i> GPM with a drawdown of _____ ft. after _____ hours of pumping		

WELL DATA		
Well Depth <i>130'</i>	Casing Diameter (In.) <i>4"</i>	Casing Length (Ft.) <i>92</i>
Type of Casing <i>PVC</i>	Hole Depth <i>130</i>	Depth to Static Water Level <i>6'</i>
TYPE OF COMPLETION: (Circle One or More): Gravel Packed, Underreamed, <input checked="" type="radio"/> Telescoped, Natural Development, Open Hole, Other (Describe) _____		
Top of Lap Pipe or Reduction in Casing FEET IF TELESCOPED OR MORE THAN ONE SCREEN: USE BACK PAGE		

LOG DATA	
TYPE OF LOG RUN (Circle One): <input checked="" type="radio"/> No Log Run, Electric, Gamma Ray, Density, Sonic, Neutron, Other (Describe) _____	
Name of Organization Running Log	

SCREEN DATA		
Diameter - Inches <i>2"</i>	Length - Feet <i>33'</i>	Slot Size - Inches <i>.013</i>
Screen Type <i>PVC</i>	Depth to Bottom - Feet	

GEOLOGIC DATA (Office Use Only)			
Surface Elev.	Geologic Unit	Unit Thickness	Depth to Top
Subs. SWL	Date	Analysis	Aquifer Test


Driller's Remarks

DESCRIPTION OF FORMATIONS ENCOUNTERED	FROM	TO
<i>Red. Sandy Clay</i>	<i>0</i>	<i>9</i>
<i>Sand. + gravel</i>	<i>9</i>	<i>31</i>
<i>Sandy Clay</i>	<i>31</i>	<i>51</i>
<i>Hood Clay</i>	<i>51</i>	<i>59</i>
<i>Sandy clay</i>	<i>59</i>	<i>70</i>
<i>Hood clay</i>	<i>70</i>	<i>78</i>
<i>Sandy clay</i>	<i>78</i>	<i>86</i>
<i>Clay</i>	<i>86</i>	<i>99 1/2</i>
<i>sand stream</i>	<i>99 1/2</i>	<i>127 1/2</i>
<i>Rock</i>	<i>127</i>	<i>127 1/2</i>
<i>Clay</i>	<i>127 1/2</i>	<i>130</i>

RECEIVED	
MAY 11 1987	
Department of Natural Resources Bureau of Land & Water Resources	
IF MORE SPACE IS NEEDED, USE BACK	

If well telescopes please sketch and show depths.

GROUND LEVEL

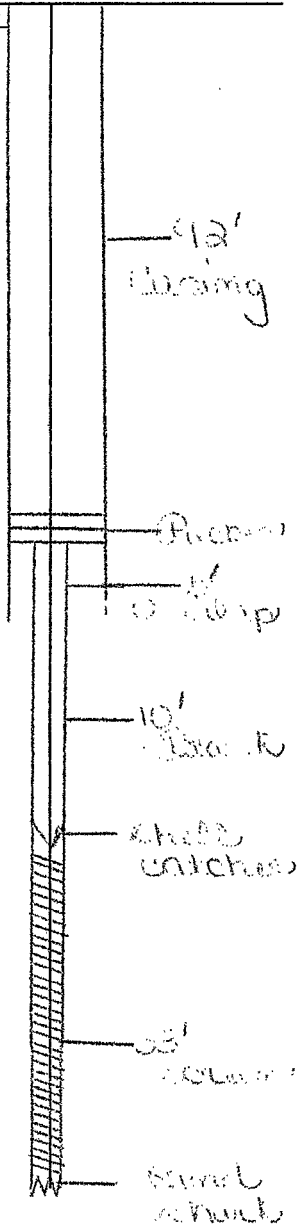

SECTION _____

Please indicate well location X.

ADDITIONAL INFORMATION

[Area with horizontal lines for additional information]

If more than one screen, show location of each on sketch.