

MISSISSIPPI DEPARTMENT OF NATURAL RESOURCES
Bureau of Land and Water Resources

P.O. Box 10631
Jackson, Mississippi 39209
WATER WELL DRILLERS LOG

COUNTY WELL LOCATED <i>Louisa</i>	
WELL NUMBER <i>Q923D</i>	CODED
DATE WELL COMPLETED <i>8-19-88</i>	

PERMIT NUMBER 0-379
NAME OF DRILLING FIRM Mid South Drilling
Rt. 1 Carrollton, AL

NAME & MAILING ADDRESS OF LANDOWNER O.C. Electric (contractor)			
2002 4th Ave. North			
Columbus, MS 39701			
WELL LOCATION:	SEC 17	TOWNSHIP 20	RANGE 19
DISTANCE 2 1/2 Miles	DIRECTION Due E	NEAREST TQWN of Stateline	
OTHER LANDMARK			
WELL PURPOSE: Home, Irrigation, Municipal, Industrial, Fish Pond, etc. home			

PUMP DATA		
PUMP TYPE (Circle One): Submersible, Turbine, Jet, Flowing Well, Other (Describe) _____		
POWER TYPE (Circle One): Electric, Tractor, Diesel, Gasoline, Butane, Other (Describe) _____		
Pump Capacity (GPM)	No. of Stages	Setting Depth FT.
PUMP TEST		
Well yielded _____ GPM with a drawdown of _____ ft. after _____ hours of pumping		

WELL DATA		
Well Depth 295'	Casing Diameter (In.) 4"	Casing Length (Ft.) 120'
Type of Casing PVC	Hole Depth <i>gab</i> 295'	Depth to Static Water Level flowing 4gpm
TYPE OF COMPLETION: (Circle One or More): Gravel Packed, Underreamed, Telescoped, Natural Development, Open Hole , Other (Describe) _____		
Top of Lap Pipe or Reduction in Casing FEET IF TELESCOPED OR MORE THAN ONE SCREEN: USE BACK PAGE		

LOG DATA	
TYPE OF LOG RUN (Circle One): No Log Run Electric, Gamma Ray, Density, Sonic, Neutron, Other (Describe) _____	
Name of Organization Running Log	


SCREEN DATA		
Diameter - Inches	Length - Feet	Slot Size - Inches
Screen Type		Depth to Bottom - Feet

GEOLOGIC DATA (Office Use Only)			
Surface Elev.	Geologic Unit	Unit Thickness	Depth to Top
Subs. SWL	Date	Analysis	Aquifer Test
Driller's Remarks			

DESCRIPTION OF FORMATIONS ENCOUNTERED	FROM	TO	FORMATIONS (Continued)	FROM	TO
clay	0	10	clay w/ sand streak	122	132
snad	10	26	sand w/ clay streaks	132	145
clay	26	30	clay	145	160
clay w/sand streaks	30	50	sand	160	165
sand	50	55	clay w/sand streaks	165	178
clay	55	57	clay	178	195
sand	57	60	clay w/sand streaks	195	218
clay	60	85	clay	218	240
sand	85	105	clay w/ sand streak	240	260
sand w/clay streaks	105	115	sand	260	266
clay	115	122	IF MORE SPACE IS NEEDED, USE BACK		

If well telescopes please sketch and show depths.

GROUND LEVEL

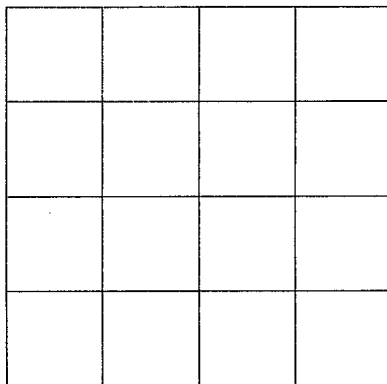

SECTION _____

Please indicate well location X.

ADDITIONAL INFORMATION

clay	266 -270
sand	270-277
sand w/ clay streaks	277-288
clay	288-295

rock at 30

118
132
134
145
162
165
178

If more than one screen, show location of each on sketch.

VA
E--

201