

MISSISSIPPI DEPARTMENT OF ENVIRONMENTAL QUALITY
Bureau of Land and Water Resources

P. O. Box 10631
Jackson, MS 39289-0631
WATER WELL DRILLERS LOG

COUNTY WELL LOCATED Sounders
WELL NUMBER Q2031
DATE WELL COMPLETED 1/24/92

PERMIT NUMBER
NAME OF DRILLING FIRM Clardy Well Drilling Co.
Columbus, Me.

NAME & MAILING ADDRESS OF LANDOWNER Mr. Frankie Sedawout			
896 Kuncade Rd.			
Columbus, Me. 39104			
WELL LOCATION:	SEC	TOWNSHIP	RANGE
	18	20 S	19 W
DISTANCE	DIRECTION	NEAREST TOWN	
8 1/2 Miles	S.	of Columbus	
OTHER LANDMARK			
WELL PURPOSE: Home, Irrigation, Municipal, Industrial, Fish Pond, etc. Home			

PUMP DATA			
PUMP TYPE (Circle One): <input checked="" type="checkbox"/> Submersible, <input type="checkbox"/> Turbine, <input type="checkbox"/> Jet <input type="checkbox"/> Flowing Well, <input type="checkbox"/> Other (Describe) _____			
POWER TYPE (Circle One): <input checked="" type="checkbox"/> Electric, <input type="checkbox"/> Tractor, <input type="checkbox"/> Diesel, <input type="checkbox"/> Gasoline, <input type="checkbox"/> Butane, <input type="checkbox"/> Other (Describe) _____ H/P _____			
Pump Capacity (GPM) 900	No. of Stages 9	Setting Depth 60' FT.	
PUMP TEST			
Well yielded _____ GPM with			
a drawdown of _____ ft.			
after _____ hours of pumping			

WELL DATA		
Well Depth 142'	Casing Diameter (In.) 4"	Casing Length (Ft.) 87'
Type of Casing PVC	Hole Depth 142	Depth to Static Water Level 9'
TYPE OF COMPLETION: (Circle One or More): <input type="checkbox"/> Gravel Packed, <input type="checkbox"/> Underreamed, <input type="checkbox"/> Telescoped, <input type="checkbox"/> Natural Development, <input type="checkbox"/> Open Hole, <input type="checkbox"/> Other (Describe) _____		
Top of Lap Pipe or Reduction in Casing		
FEET	IF TELESCOPED OR MORE THAN ONE SCREEN: USE BACK PAGE	

LOG DATA	
TYPE OF LOG RUN (Circle One): <input type="checkbox"/> No Log Run, <input type="checkbox"/> Electric, <input type="checkbox"/> Gamma Ray, <input type="checkbox"/> Density, <input type="checkbox"/> Sonic, <input type="checkbox"/> Neutron, <input type="checkbox"/> Other (Describe) _____	
Name of Organization Running Log	

SCREEN DATA		
Diameter - Inches	Length - Feet	Slot Size - Inches
Screen Type	Depth to Bottom - Feet	

GEOLOGIC DATA (Office Use Only)			
Surface Elev.	Geologic Unit	Unit Thickness	Depth to Top
Subs. SWL	Date	Analysis	Aquifer Test
Driller's Remarks			


DESCRIPTION OF FORMATIONS ENCOUNTERED	FROM	TO	FORMATIONS (Continued)	FROM	TO
Sandy Clay	0	8	Sandy Clay	140	142
sand & gravel	8	22	MEG		
Clay	22	44	MEG		
Sandy Clay	44	52	MEG		
Clay	52	62	MEG		
Sandy Clay	62	71	MEG		
Clay	71	103	MEG		
Sandy Clay	103	119	MEG		
Fine sand	119	122	MEG		
Rocky sand streak	122	131	MEG		
Clay	131	140	MEG		

Dept. of Environmental Quality
Bureau of Land & Water Resources

IF MORE SPACE IS NEEDED, USE BACK

If well telescopes please
sketch and show depths.

GROUND LEVEL

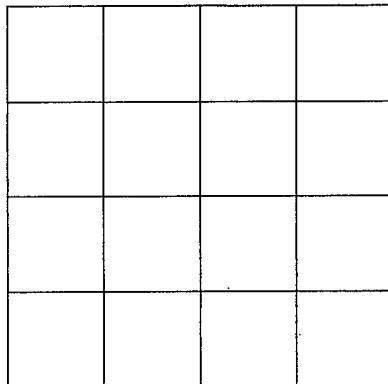

SECTION _____

Please indicate well location X.

ADDITIONAL INFORMATION

If more than one screen,
show location of each on sketch.