

MISSISSIPPI DEPARTMENT OF ENVIRONMENTAL QUALITY
Bureau of Land and Water Resources

P. O. Box 10631
Jackson, MS 39289-0631
WATER WELL DRILLERS LOG

COUNTY WELL LOCATED Lowndes	
WELL NUMBER 1909	CODED
2043	
DATE WELL COMPLETED 6-20-94	

PERMIT NUMBER 0-379
NAME OF DRILLING FIRM Mid South Drilling Co.
Carrollton, AL 35447

NAME & MAILING ADDRESS OF LANDOWNER O. C. Electric (Contractor)			
P. O. Box 581			
Columbus, MS 39703			
WELL LOCATION:	SEC 16	TOWNSHIP 20	RANGE 19
DISTANCE 12	DIRECTION S	NEAREST TOWN Columbus	
OTHER LANDMARK near river			
WELL PURPOSE: Home, Irrigation, Municipal, Industrial, Fish Pond, etc. home			

PUMP DATA		
PUMP TYPE (Circle One): Submersible, Turbine, Jet, Flowing Well, Other (Describe) _____		
POWER TYPE (Circle One): Electric, Tractor, Diesel, Gasoline, Butane, Other (Describe) _____ H/P _____		
Pump Capacity (GPM)	No. of Stages	Setting Depth FT.
PUMP TEST Well yielded _____ GPM with a drawdown of _____ ft. after _____ hours of pumping		

WELL DATA		
Well Depth 250	Casing Diameter (In.) 4"	Casing Length (Ft.) 152
Type of Casing PVC	Hole Depth 250	Depth to Static Water Level 3'
TYPE OF COMPLETION: (Circle One or More): Gravel Packed, Underreamed, Telescoped, Natural Development, Open Hole , Other		
Top of Lap Pipe or Reduction in Casing FEET IF TELESCOPED OR MORE THAN ONE SCREEN: USE BACK PAGE		

LOG DATA	
TYPE OF LOG RUN (Circle One): Electric, Gamma Ray, Density, Sonic, Neutron, Other (Describe) _____ No Log Run	
Name of Organization Running Log	

SCREEN DATA		
Diameter - Inches	Length - Feet	Slot Size - Inches
Screen Type		Depth to Bottom - Feet


GEOLOGIC DATA (Office Use Only)			
Surface Elev.	Geologic Unit	Unit Thickness	Depth to Top
Subs. SWL	Date	Analysis	Aquifer Test
Driller's Remarks			

DESCRIPTION OF FORMATIONS ENCOUNTERED	FROM	TO	FORMATIONS (Continued)	FROM	TO
clay	000	005	sand	176	191
sand	005	010	clay	191	198
sand & gravel	010	020	sand w/clay streaks	198	242
clay	020	075	clay w/sand streaks	242	248
sand	075	080	clay	248	250
sand w/clay streaks	080	123			
clay	123	130			
sand	130	136			
clay	136	162			
sand	162	165			
clay	165	176			
IF MORE SPACE IS NEEDED, USE BACK					

RECEIVED
JUN 27 1994

If well telescopes please sketch and show depths.

GROUND LEVEL

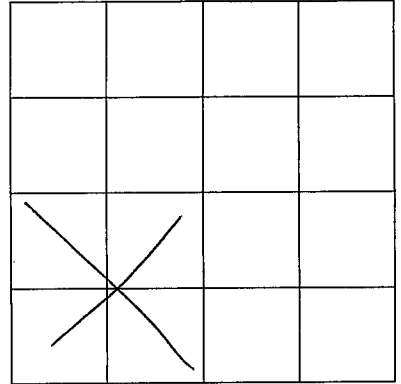

SECTION 16

Please indicate well location X.

ADDITIONAL INFORMATION

If more than one screen,
show location of each on sketch.