


ELOG # 150

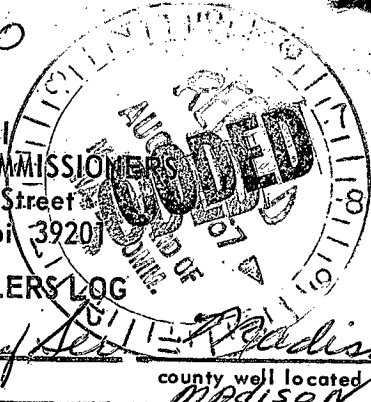

MISSISSIPPI BOARD OF WATER COMMISSIONERS
416 North State Street
Jackson, Mississippi 39201

WATER WELL DRILLERS LOG

Madison
A25
1-67
Elog # 150
1-12-67
date well completed

Forest Drilling Co. firm name
Madison county well located

LANDOWNER: Cameron
Picks (mailing address)

WELL LOCATION: 4 sec. 31 T12N R15E
5 miles East of Picks (distance) (direction) (nearest town)

WELL PURPOSE: Community Well (home, irrigation, municipal, industrial)

WELL COMPLETION DATA:
(1) diameter (inches) 5" Hole
(2) total depth (feet) 1632'
(3) static water level (feet) 80 below top of ground.
(4) casing NONE (material) (depth) (size) if telescope see back.
(5) screen NONE (length) (depth to top) (size) (material)
(6) pump NONE (HP) (yield gpm) (type power)
(7) electric log yes (yes or no) U.S. Geological (organization running log)
(8) how well bottom plugged


description of formations encountered	from	to
Clay + Red Sand	0	20
Red Sand		55
Clay		61
Clay + Sths Sand		81
Fine Sand		122
Sand		187
Rock		188
Clay + Sths Sand		225
F. Sand + Sths Clay		246
G. Sand + Clay		266
Clay + Sths Sand		329
Clay + Sths Sand		350
Shale		370
Soft Shale		391
Shale + silt sand		412
F. Sand + Sths Clay		432
Fine Sand		476
Shale + Sths Sand		478
F. Sand + Shale		574
F. Sand + Sths Clay		635
Fine Sand		579
Soft Shale + Fine Sand		596
Clay Shale + Silt		638
Shale		658
Fine Sand		678
Soft shale + silt sand		698
Shale		718
Shale + Sths Sand		738
Shale		798
Shale + Sths Sand		830
Shale		832
Shale (Hard)		899
Rock		899
Hard shale		919
Shale + Sths Sand		930
Rock		940
Shale		979
Clay + Sths Sand		1007
Rock + Sths Sand		1037
Rock		1013
Hard Shale		1063

DRILLERS REMARKS: This was a test hole only.
(over)

If well telescopes please sketch and show depths.

GROUND LEVEL

SW, NE, SE

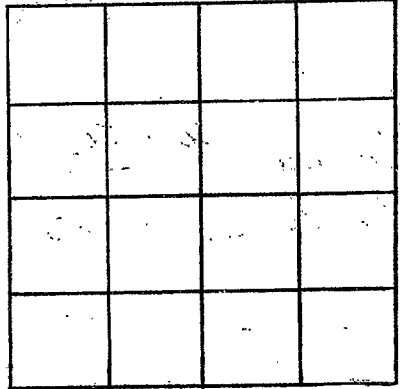

SECTION _____

Please indicate well location X.

ADDITIONAL INFORMATION

*Runner would not
accept well
test could
have been
made at 580'*

1063 to 1067 Rock
1067 to 1083 Hard shale + Rock
1083 to 1107 Shale + Sth. Rock
1004 to 1124 Sth. Rock
1124 to 1174 Hard shale + Rock
1164 to 1198 Shale + Rock
1198 to 1219 Shale
1219 to 1322 Soft shale
1322 to 1345 Soft shale + Sth. Rock
1345 to 1353 Soft shale + Sth. Rock
1353 to 1443 Soft shale + Sth. Rock
1443 to 1463 Shale
1463 to 1478 Hard shale + Rock
1483 to 1503 Soft shale
1503 to 1523 Shale
1523 to 1573 Soft shale + Sth. Rock
1573 to 1583 Shale
1573 to 1578 Soft shale + Sth. Rock
1578 to 1593 Shale
1593 to 1613 Soft shale
1613 to 1633 Shale

If more than one screen,
show locations of each on sketch.