

MADISON
A 26
4-10-67

MISSISSIPPI
BOARD OF WATER COMMISSIONERS
416 North State Street
Jackson, Mississippi 39201

CODED

WATER WELL DRILLERS LOG

4/10 date well completed 1967 Forest Drilling firm name Madison county well located

LANDOWNER:	description of formations encountered	from	to
Cameron Water Basin	Red Clay	0	40
Guckens, Miss	Clay	40	56
(mailing address)	Strs of fine sand + clay	56	185
	fine sand	185	237
	rock	237	240
	strs sand + clay	240	289
	Clay	289	329
	strs clay + sand	329	380
	shale	380	494
	sand	494	560
	shale	560	563
	fine sand	563	637
	med sand	637	719
	shale	719	777
	shale + strs rock	777	797
	soft shale	797	870
	rock + shale	870	876
	hard shale + rock	876	926
	shale + strs rock	926	988
	strs hard rock + sh	988	1292
	strs fine sand + shale	1292	1354
	med sand + strs clay	1354	1374
	med sand	1374	1409
	fine sand + oil	1409	1504

LANDOWNER:

description of formations encountered

from

to

Cameron Water Basin
Guckens, Miss
(mailing address)

WELL LOCATION:

sec 25 T 12 N R 35 E
S W

(distance) miles (direction) of (nearest town)

WELL PURPOSE: Community
(home, irrigation, municipal, industrial)

WELL COMPLETION DATA:

- (1) diameter (inches) 6"
- (2) total depth (feet) 1408
- (3) static water level (feet) 80 below top of ground
- (4) casing Steel 1338 (material) (depth)
- (5) screen 40 1368 (length) (depth to top)
4" (size) (material)
- (6) pump 10 102 @ 60 l (HP) (yield gpm)
230/3 ph (type power)
- (7) electric log Yes (yes or no)
U.S. Geological (organization running log)
- (8) how well bottom plugged

RECEIVED
SEP 11 1978

MISS. BD. OF WATER COMMISSIONERS


CODED

DRILLERS REMARKS:

Just for your records

If well telescopes please sketch and show depths.

GROUND LEVEL

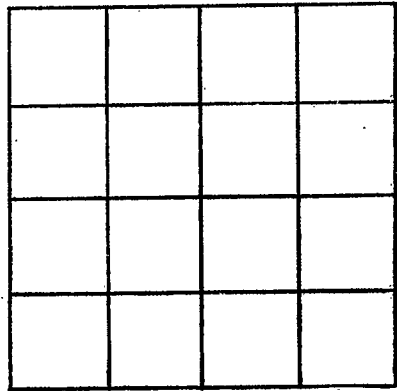

SECTION _____

Please indicate well location X.

ADDITIONAL INFORMATION

If more than one screen, show locations of each on sketch.