

A28

10-8-63

WATER WELL DRILLERS LOG

CODED

Date: 10/8, 1963, Driller: M. Kay County Madison
(Name)

(1) Owner of Land Leo Parker
(Name)
Parkview
(Address)

(2) Location: 1/4, 1/4, Sec. 23 T12R9E,
8 miles NW, of Camden
(distance) (direction) (Nearest Town)

(3) Topography: (Hilly) (Flat) (Level)

(4) Purpose of Well: (Domestic Irrigation)
 (Municipal, Industrial, Other)

Description & Color of Materials Sand, Clay, Red Clay, Shell, etc.	Thick- ness Feet	Depth Feet
Red Sand	0	21
Red Sand	21	42
White Sand	42	63
Fine Reddish Sand	63	84
Med Sand	84	105
Med Sand	105	110
Red Pine		

Information upon completion of well:

(1) Diameter 2 inches.

(2) Total Depth 110 feet.

(3) Water Level 84 feet below top of ground.

(4) Cased to _____, Size _____

(5) Screen: Size 007, Length 10


(6) Were any formations sealed against pollution?
 _____ yes, no.

If YES, depth of formation _____

Why _____

Drillers Remarks: _____

CODED

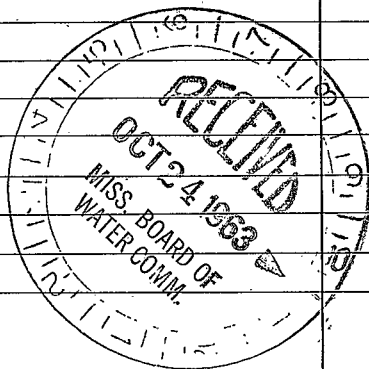

(Use Back Side)

Well No.

