

MISSISSIPPI DEPARTMENT OF NATURAL RESOURCES

Bureau of Land and Water Resources

Southport Mall

P.O. Box 10631

CODED

Jackson, Mississippi 39209

WATER WELL DRILLERS LOG

Griner Drilling Service, Inc.

Madison

Madison  
A 30  
2-17-81

2-17-81

date well completed

firm name

county well located

LANDOWNER:

Par-co Drilling  
P.O. Box 873  
Natchez, Ms. 39120  
(mailing address)

description of formations encountered

from

to

Top Soil 0 21

clay 21 50

sand 50 140

clay CODED 140 147

WELL LOCATION:

#1 Dixon 2 3/4 N 12 W 3 E  
N. Pickens  
miles of (nearest town)

WELL PURPOSE: oil field supply

WELL COMPLETION DATA:

- (1) diameter (inches) 3"
- (2) total depth (feet) 147'
- (3) static water level (feet) 20' below top of ground.
- (4) casing steel 126' (material), (depth)  
3" (size) if telescope see back.
- (5) screen 42' 84' (length), (depth to top)  
3" perforated (size), (material)
- (6) pump - 65 (HP), (yield gpm)  
AC (type power)
- (7) electric log (yes or no)

(organization running log)

- (8) how well bottom plugged orange  
peel

DRILLERS REMARKS:


DEPT. OF NATURAL RESOURCES  
BUREAU OF LAND & WATER RESOURCES

MAR 31 1981

RECEIVED

If well telescopes please sketch and show depths.

GROUND LEVEL

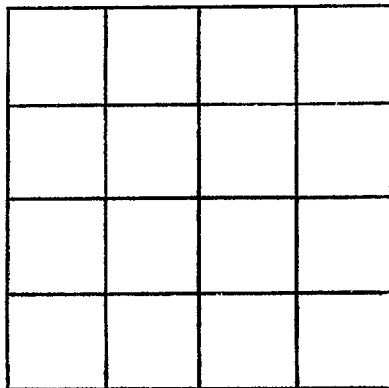

SECTION \_\_\_\_\_

Please indicate well location X.

ADDITIONAL INFORMATION

If more than one screen, show locations of each on sketch.