

Madison
 A 2007
 5-28-81

MISSISSIPPI
 BOARD OF WATER COMMISSIONERS
 416 North State Street
 Jackson, Mississippi 39201

WATER WELL DRILLERS LOG

5-28 1981 THOMAS MADISON
 date well completed firm name county well located

LANDOWNER: SAM BARRELL
 R+1
 GOODMAN, MISS
 (mailing address)


description of formations encountered	from	to
Pipe CLAY	0	37
SAND	37	89

WELL LOCATION:
 sec. 28 T. 12 N. R. 4 E
 S W
 16 1/2 miles NE of Canton
 (distance) (direction) (nearest town)

WELL PURPOSE:
 (home, irrigation, municipal, industrial)


- WELL COMPLETION DATA:
- (1) diameter (inches) 2
 - (2) total depth (feet) 89
 - (3) static water level (feet) 66 ^{below} top of ground
 - (4) casing PVC 79
 (material) (depth)
 (size) If telescope see back.
 - (5) screen 10 79
 (length) (depth to top)
 2" 10 slot PVC
 (size) (material)
 - (6) pump 1 6
 (HP) (yield gpm)
 Elec
 (type power)
 - (7) electric log NO
 (yes or no)
 - (organization running log)
 - (8) how well bottom plugged POINT

DRILLERS REMARKS: 1 Hp Gould
 Old TANK 220'

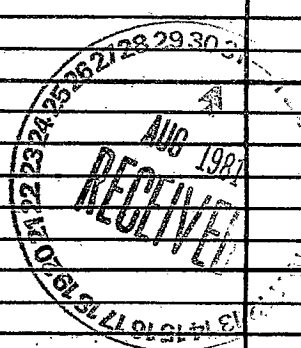

If well telescopes please sketch and show depths.

GROUND LEVEL

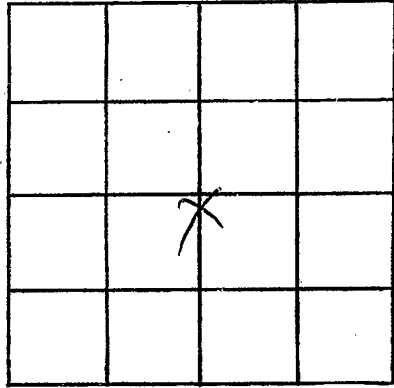

SECTION 28

Please indicate well location X.

ADDITIONAL INFORMATION

If more than one screen, show locations of each on sketch.