

MISSISSIPPI DEPARTMENT OF NATURAL RESOURCES

Bureau of Land and Water Resources

Southport Mall

P.O. Box 10631

Jackson, Mississippi 39209

WATER WELL DRILLERS LOG

MADISON  
A 0003

10/21 19 85 THOMAS & SON MADISON CO  
date well completed firm name county well located

LANDOWNER: Bob + Sylvia Scott

description of formations encountered

from to

Goodwin Mill  
(mailing address)

Red Dirt 0 18  
Red Chalk 18 36  
Sand & Chalk 36 62  
White C Sand 62 90

WELL LOCATION:

sec. 22 T. 12 N. R. 4 E.  
S W  
3 miles North of Cameron  
(distance) (direction) (nearest town)

WELL PURPOSE:

(home, irrigation, municipal, industrial)

WELL COMPLETION DATA:

- (1) diameter (inches) 4"
- (2) total depth (feet) 90'
- (3) static water level (feet) 20' below top of ground.
- (4) casing PVC, 90' (material) (depth)  
4" (size) If telescope see back.
- (5) screen 10', 90' (length) (depth to top)  
4", PVC (size) (material)
- (6) pump 1/2, 10 (HP) (yield gpm)  
Electric (type power)
- (7) electric log No (yes or no)

(organization running log)

(8) how well bottom plugged Screen


RECEIVED  
NOV 22 1985

Department of Natural Resources  
Bureau of Land & Water Resources

DRILLERS REMARKS:

If well telescopes please sketch and show depths.

GROUND LEVEL

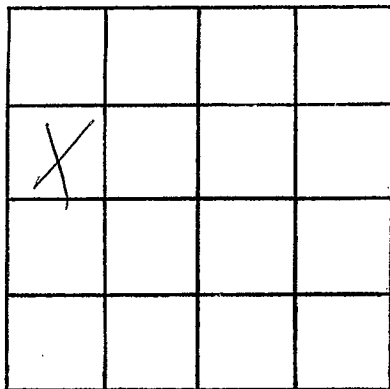

SECTION \_\_\_\_\_

Please indicate well location X.

ADDITIONAL INFORMATION

If more than one screen,  
show locations of each on sketch.