

MISSISSIPPI DEPARTMENT OF NATURAL RESOURCES
Bureau of Land and Water Resources

P.O. Box 10631
Jackson, Mississippi 39209
WATER WELL DRILLERS LOG

MADISON
COUNTY WELL LOCATED
~~Madison~~
WELL NUMBER **B 2001** CODED
12/24/19
DATE WELL COMPLETED
Madison

PERMIT NUMBER
NAME OF DRILLING FIRM
THOMAS DRILLING
206 GRAHAM ST.
GARTHAGE, MISS. 39051

NAME & MAILING ADDRESS OF LANDOWNER
David Kennop
Rt1- Box 60
Camden, MS. 39045
WELL LOCATION: SEC **26** TOWNSHIP **12 N** RANGE **5 E**
DISTANCE **5** Miles **E** of **Corner**
OTHER LANDMARK
1/2 miles NE of Cemetery
WELL PURPOSE: Home, Irrigation, Municipal, Industrial, Fish Pond, etc.
Home

PUMP DATA

PUMP TYPE (Circle One):
Submersible, Turbine, **Jet** Flowing Well,
Other (Describe) _____
POWER TYPE (Circle One):
Electric, Tractor, Diesel, Gasoline, Butane,
Other (Describe) _____ H/P _____
Pump Capacity (GPM) **9** No. of Stages **2** Setting Depth **40** FT.
PUMP TEST
Well yielded **9** GPM with
a drawdown of **2-3** ft.
after **1** hours of pumping

WELL DATA

Well Depth 85	Casing Diameter (In.) 2"	Casing Length (Ft.) 75'
Type of Casing PVC	Hole Depth 2"	Depth to Static Water Level 22'

TYPE OF COMPLETION: (Circle One or More):
Gravel Packed, Underreamed, Telescoped,
Natural Development, Open Hole, Other
(Describe) _____
Top of Lap Pipe or Reduction in Casing
FEET IF TELESCOPED OR MORE THAN ONE SCREEN: USE BACK PAGE

LOG DATA

TYPE OF LOG RUN (Circle One):
Electric, Gamma Ray, Density, Sonic, Neutron,
Other (Describe) **NO**
Name of Organization Running Log

SCREEN DATA

Diameter - Inches 2"	Length - Feet 10	Slot Size - Inches .10
Screen Type PVC Wrappell	Depth to Bottom - Feet 85	

GEOLOGIC DATA (Office Use Only)

Surface Elev.	Geologic Unit	Unit Thickness	Depth to Top
Subs. SWL	Date	Analysis	Aquifer Test


Driller's Remarks

DESCRIPTION OF FORMATIONS ENCOUNTERED	FROM	TO	FORMATIONS (Continued)	FROM	TO
BROWN DIRT		04	RECEIVED NOV 24 1989 Department of Natural Resources Bureau of Land & Water Resources		
Red DIRT + SAND	4	20			
yellow SAND	20	40			
Gray CHALK	40	45			
GRAY SAND	45	85			

IF MORE SPACE IS NEEDED, USE BACK

If well telescopes please sketch and show depths.

GROUND LEVEL

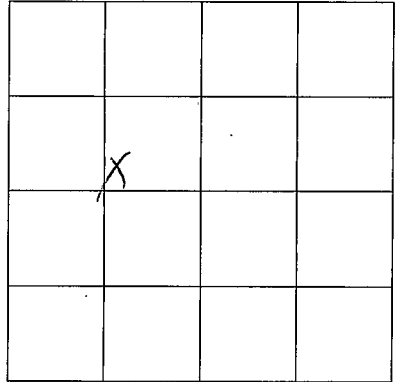

SECTION 25

Please indicate well location X.

ADDITIONAL INFORMATION

If more than one screen,
show location of each on sketch.