

WATER WELL DRILLERS LOG

8-16-62

Date Aug 16, 1962 Driller: M^c Kay Dally County Madison

(1) Owner of Land: Ralph Heath
(Name)
Canton Miss
(Address)

(2) Location: 1/4, 1/4, Sec. T R ,
8 miles W of Cambus,
(distance) (direction) (Nearest Town)

(3) Topography:
(Hilly) (Flat) (Level)

(4) Purpose of Well: Gen
(Domestic Irrigation Municipal, Industrial, Other)

Description & Color of Materials Sand, Clay, Red Clay, Shell, etc.	Thick- ness Feet	Depth Feet
<u>White Clay</u>	<u>0</u>	<u>31</u>
<u>Brown Clay</u>	<u>21</u>	<u>42</u>
<u>" " - Sand</u>	<u>42</u>	<u>63</u>
<u>Sandy Clay</u>	<u>63</u>	<u>84</u>
<u>" " " "</u>	<u>84</u>	<u>105</u>
<u>" white clay Strac</u>	<u>105</u>	<u>126</u>
<u>Clay - Sand Strac</u>	<u>126</u>	<u>147</u>
<u>Sand -</u>	<u>147</u>	<u>150</u>

Information upon completion of well:

(1) Diameter 2 inches.

(2) Total Depth 150 feet.

(3) Water Level 49 feet below top of ground.

(4) Cased to , Size .

(5) Screen: Size 007, Length 5 ft.


(6) Were any formations sealed against pollution?
 yes, no.

1/2 HP. Rod Pump
42 gal Tank

If YES depth of formation

Why

Drillers Remarks:

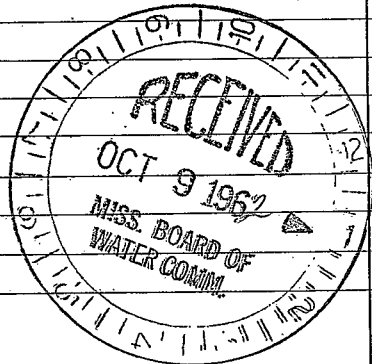

(Use Back Side)

Well No.

