

Madison
C30
8-20-68

MISSISSIPPI
BOARD OF WATER COMMISSIONERS
416 North State Street
Jackson, Mississippi 39201

CODED

CODED

WATER WELL DRILLERS LOG

8-20 1968 date well completed
East Dillingham Madison firm name
county well located

LANDOWNER: Bill Pusley
90 Pusley Chev. Co.
Pickens, Miss.
(mailing address)

description of formations encountered

from to

Clay	0	61
blue clay		102
clay + silt + sand		122
fine sand + silt clay		143
fine sand	0	184

WELL LOCATION:

sec. 15 T 11 N R 3 E
5 miles 50 of Pickens
(distance) (direction) (nearest town)

WELL PURPOSE: Home
(home, irrigation, municipal, industrial)

WELL COMPLETION DATA:

- (1) diameter (inches) 2"
- (2) total depth (feet) 184 ft
- (3) static water level (feet) 76 below top of ground
- (4) casing (material) 174 ft (depth)
- 2" if telescope see back. (size)
- (5) screen 10 ft, 174 (length) (depth to top)
- 2" Stainless Steel (size) (material)
- (6) pump 2 HP, 10 (HP) (yield gpm)
- Electric (type power)
- (7) electric log No (yes or no)

CODED

(organization running log)

Producers

(8) how well bottom plugged 2/3


JAN - 8 1969

MISS. DEPT. OF
WATER RESOURCES

DRILLERS REMARKS:

If well telescopes please sketch and show depths.

GROUND LEVEL

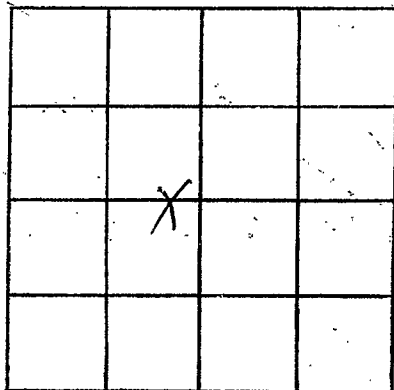

SECTION 15

Please indicate well location X.

ADDITIONAL INFORMATION

If more than one screen,
show locations of each on sketch.