

CODED

Madison
C 31
8-11-69

MISSISSIPPI
BOARD OF WATER COMMISSIONERS
416 North State Street
Jackson, Mississippi 39201

WATER WELL DRILLERS LOG

8-11-69 data well completed
Thomas & Son firm name
Madison county well located

LANDOWNER: Mr. John Higgins
Hwy 51 N.
Canton, Miss.
(mailing address)

description of formations encountered	from	to
	Red CLAY	0
Red SAND	30	50
SOFT CHALK	50	84
FINE SAND & Ch	84	120
White SAND	120	131

WELL LOCATION:
sec 28 T. 11 N. R. 3 E
S W
10 1/2 miles N of Canton
(distance) (direction) (nearest town)

WELL PURPOSE:
(home) irrigation, municipal, industrial

- WELL COMPLETION DATA:
- (1) diameter (inches) 2
 - (2) total depth (feet) 131
 - (3) static water level (feet) 45 ^{below} _{above} top of ground.
 - (4) casing PVC 127
(material) (depth)
2 if telescope see back.
(size)
 - (5) screen 5 127
(length) (depth to top)
1 1/4 slot 5/8"
(size) (material)
 - (6) pump 3/4 5
(HP) (yield gpm)
Elec
(type power)
 - (7) electric log NO
(yes or no)
- (organization running log)
- (8) how well bottom plugged


NOV 29 1969

MISSISSIPPI
STATE
WATER BOARD

DRILLERS REMARKS:

If well telescopes please sketch and show depths.

GROUND LEVEL

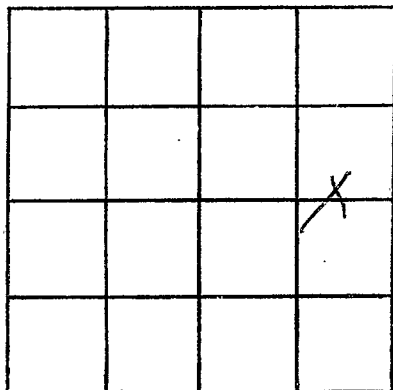

SECTION 28

Please indicate well location X.

ADDITIONAL INFORMATION

If more than one screen, show locations of each on sketch.