

Madison
C 32
5-16-70

MISSISSIPPI
 BOARD OF WATER COMMISSIONERS
 416 North State Street
 Jackson, Mississippi 39201

CODED

WATER WELL DRILLERS LOG


May 16 1970 John Davis Madison
 date well completed firm name county well located

LANDOWNER:	description of formations encountered	from	to
<u>Mrs Allen Waits</u> <u>Allison wells</u> (mailing address)	<u>Clay</u> <u>sand</u>	<u>0</u> <u>40</u>	<u>40</u> <u>70</u>
WELL LOCATION: sec. <u>33</u> T. <u>11</u> N. R. <u>3</u> E. <u>044</u> <u>9</u> miles <u>N</u> of <u>Canton</u> (distance) (direction) (nearest town)			
WELL PURPOSE: (home, irrigation, municipal, industrial)			
WELL COMPLETION DATA:			
(1) diameter (inches) <u>2"</u>			
(2) total depth (feet) <u>70'</u>			
(3) static water level (feet) <u>22</u> <u>below</u> above top of ground.			
(4) casing <u>Galv</u> <u>65'</u> (material) (depth)			
<u>2"</u> if telescope see back. (size)			
(5) screen <u>5'</u> <u>65'</u> (length) (depth to top)			
<u>.007</u> <u>2"</u> <u>SS</u> (size) (material)			
(6) pump <u>1/2</u> <u>7</u> (HP) (yield gpm)			
<u>Elec</u> (type power)			
(7) electric log <u>NO</u> (yes or no)			
(organization running log)			
(8) how well bottom plugged <u>uvf</u> <u>pin</u>			
DRILLERS REMARKS:			

JUN 3 1970
 MISS. BD. OF
 WATER COMM.

If well telescopes please sketch and show depths.

GROUND LEVEL

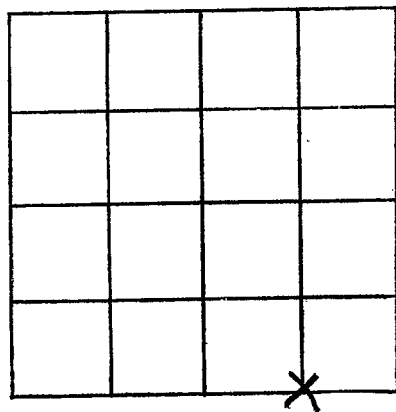

SECTION 33

Please indicate well location X.

ADDITIONAL INFORMATION

If more than one screen, show locations of each on sketch.