

MADISON  
C33  
4-7-71

MISSISSIPPI  
BOARD OF WATER COMMISSIONERS  
416 North State Street  
Jackson, Mississippi 39201

ELOG # 207

CODED

WATER WELL DRILLERS LOG

4/7

1971 Jack Guinn

Madison

date well completed

firm name

county well located

LANDOWNER: P. Sargent

description of formations encountered

from

to

(mailing address)

WELL LOCATION:

sec 35 T 11 N R 3 E

10 miles E of Canton  
(distance) (direction) (nearest town)

clay	0	15
yellow sand	15	60
gray sand	60	70
sandy shell	70	120
gray sand	120	130
blue clay	130	299
sandy shell	299	368
gray sand	368	484
chopped sand	484	520

WELL PURPOSE:

(home, irrigation, municipal, industrial)

WELL COMPLETION DATA:

- (1) diameter (inches) 4 in.
- (2) total depth (feet) 520
- (3) static water level (feet) 70 below top of ground
- (4) casing Black 315  
(material) (depth)

- (5) screen 4 in. if telescope see back.  
(size)
- (5) screen 20 420  
(length) (depth to top)

- (6) pump 2 Johnson  
(size) (material)
- (6) pump 2 50  
(HP) (yield gpm)

- (7) electric log R.C.A.  
(type power)

- (7) electric log yes  
(yes or no)
- U.S.G.S.  
(organization running log)

- (8) how well bottom plugged back  
wash valve

CODED

JUL 13 1971


DRILLERS REMARKS:

MISS. BD. OF  
WATER COMM.

If well telescopes please sketch and show depths.

GROUND LEVEL

*water level 70ft.  
Telescoped to  
315 to 420  
2 H.P. pump*

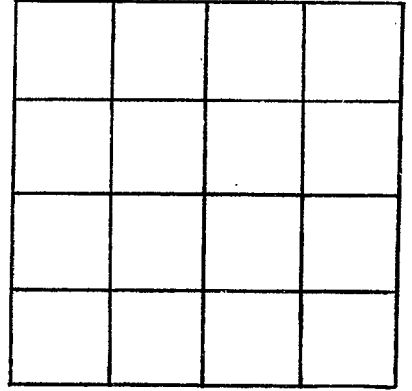

SECTION \_\_\_\_\_

Please indicate well location X.

ADDITIONAL INFORMATION

If more than one screen,  
show locations of each on sketch.