

MADISON
C 37
1-20-75

MISSISSIPPI
BOARD OF WATER COMMISSIONERS
416 North State Street
Jackson, Mississippi 39201

CODED

WATER WELL DRILLERS LOG

1-20-1975 JEECOAT DRILLING CO. Madison
date well completed firm name county well located

LANDOWNER: Robert Clark
Pickens, MS.
(mailing address)


description of formations encountered	from	to
Clay	0	20
Sand	20	61
Clay	61	130
Sand	130	150
Clay	150	180
Sand	180	250

WELL LOCATION:
sec 29 T 11 N R 3 E
5 miles South of Pickens
(distance) (direction) (nearest town)

WELL PURPOSE: Home
(home, irrigation, municipal, industrial)

- WELL COMPLETION DATA:
- (1) diameter (inches) 2"
 - (2) total depth (feet) 250
 - (3) static water level (feet) 30 below
top of ground.
 - (4) casing PVC, 238'
(material) (depth)
if telescope see back.
 - (5) screen 2" 12 ft
(length) (depth to top)
2" PVC
(size) (material)
 - (6) pump 3/4 8
(HP) (yield gpm)
Electric
(type power)
 - (7) electric log no
(yes or no)
(organization running log)
 - (8) how well bottom plugged
back wash

CODED

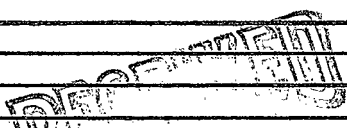


FEB 11 1975

MISS. BOARD OF WATER CONTROL

DRILLERS REMARKS:

If well telescopes please sketch and show depths.

GROUND LEVEL

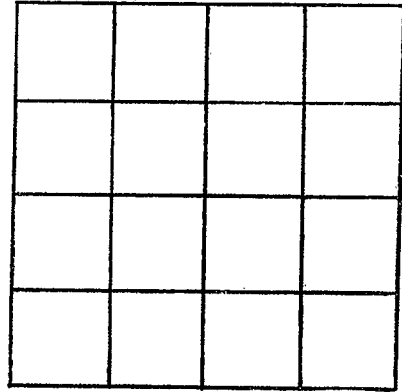

SECTION _____

Please indicate well location X.

ADDITIONAL INFORMATION

If more than one screen, show locations of each on sketch.