

MISSISSIPPI DEPARTMENT OF NATURAL RESOURCES

Bureau of Land and Water Resources

Southport Mall

P.O. Box 10631

Jackson, Mississippi 39209

WATER WELL DRILLERS LOG

MADISON
C 38
4-17-85

4-17 1985 *Thomas & Son* *Madison Co*  
 date well completed firm name county well located

LANDOWNER: *SWART Const Co*  
*Drew Miss*  
 (mailing address)

description of formations encountered	from	to
<i>Red dirt</i>	<i>0</i>	<i>18</i>
<i>White C. sand</i>	<i>18</i>	<i>50</i>

WELL LOCATION:  
 ? sec. *22* T. *10* N. R. *3* E  
*3* miles *West* of *Loeving*  
 (distance) (direction) (nearest town)

WELL PURPOSE:  
 (home, irrigation, municipal, industrial)

WELL COMPLETION DATA:

(1) diameter (inches) *2"*

(2) total depth (feet) *50'*

(3) static water level (feet) *22* below above top of ground.

(4) casing *PVC* *50'*  
 (material) (depth)  
*2"* if telescope see back.  
 (size)

(5) screen *10'* *40'*  
 (length) (depth to top)  
*2"* *PVC*  
 (size) (material)

(6) pump *1* *8*  
 (HP) (yield gpm)  
*Electric*  
 (type power)

(7) electric log *no*  
 (yes or no)  
 (organization running log)

(8) how well bottom plugged *Screen*


RECEIVED  
 MAY 14 1985

DRILLERS REMARKS:

Department of Natural Resources  
 Bureau of Land & Water Resources

If well telescopes please sketch and show depths.

GROUND LEVEL

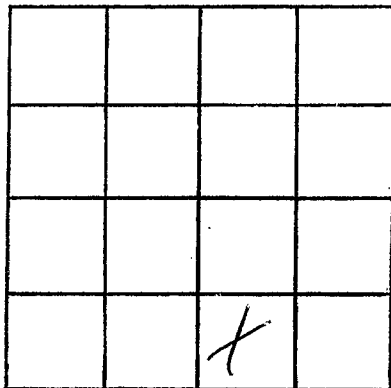

SECTION \_\_\_\_\_

Please indicate well location X.

ADDITIONAL INFORMATION

If more than one screen,  
show locations of each on sketch.