

Madison
 C 2001
 7-5-76

MISSISSIPPI
 BOARD OF WATER COMMISSIONERS
 416 North State Street
 Jackson, Mississippi 39201

WATER WELL DRILLERS LOG

July 5 1976 E. M. "Bud" CRESSWELL Madison
 date well completed firm name county well located

LANDOWNER:
 W. B. Patterson
 CANTON, MS.
 (mailing address)

description of formations encountered	from	to
Clay	0	20
Sand	20	85


WELL LOCATION:
 sec. 27 T 4 N R 3 E
 10 miles N of CANTON
 (distance) (direction) (nearest town)

WELL PURPOSE: Home
 (home, irrigation, municipal, industrial)

- WELL COMPLETION DATA:
- (1) diameter (inches) 2
 - (2) total depth (feet) 85
 - (3) static water level (feet) 50 below top of ground.
 - (4) casing Plastic 80 (material), (depth),
 2 (size) if telescope see back.
 - (5) screen 5 80 (length), (depth to top)
 2 PLASTIC (size), (material)
 - (6) pump 1 10 (HP), (yield gpm)
 0 (type power)
 - (7) electric log No (yes or no)
 0 (organization running log)

(8) how well bottom plugged?
 Plastic plug

DRILLERS REMARKS:

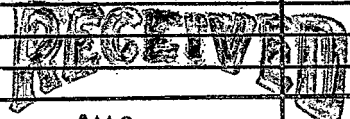


AUG 3 - 1976

MISS. BD. OF WATER COMMISSIONERS

If well telescopes please sketch and show depths.

GROUND LEVEL

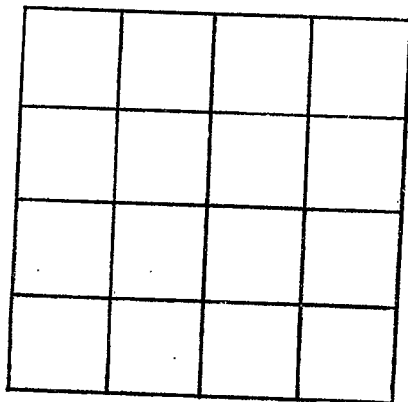

SECTION _____

Please indicate well location X.

ADDITIONAL INFORMATION

If more than one screen,
show locations of each on sketch.