

Madison

C 2008

7-7-76

MISSISSIPPI  
 BOARD OF WATER COMMISSIONERS  
 416 North State Street  
 15K Jackson, Mississippi 39201

WATER WELL DRILLERS LOG

July 7  
date well completed

1976 F.M. "Bud" Cresswell  
firm name

Madison  
county well located

LANDOWNER:

W. B. Patterson

CANTON, MS.  
(mailing address)

description of formations encountered

from

to

CLAY  
SAND

0 20  
20 110

WELL LOCATION:

sec 27 T 11 N R 3 E  
10 miles North of Canton  
(distance) (direction) (nearest town)

WELL PURPOSE: Home  
(home, irrigation, municipal, industrial)

WELL COMPLETION DATA:

- (1) diameter (inches) 2
- (2) total depth (feet) 110
- (3) static water level (feet) 50 below top of ground
- (4) casing Plastic 100  
(material) (depth)  
2 (size) if telescope see back.
- (5) screen 10 100  
(length) (depth to top)  
2 Plastic  
(size) (material)
- (6) pump 1 10  
(HP) (yield gpm)  
0 (type power)
- (7) electric log No  
(yes or no)  
0  
(organization running log)

(8) how well bottom plugged

steel plug

DRILLERS REMARKS:


RECEIVED

AUG 3 - 1976

MISS. BD. OF WATER COMMISSIONERS

If well telescopes please sketch and show depths.

GROUND LEVEL

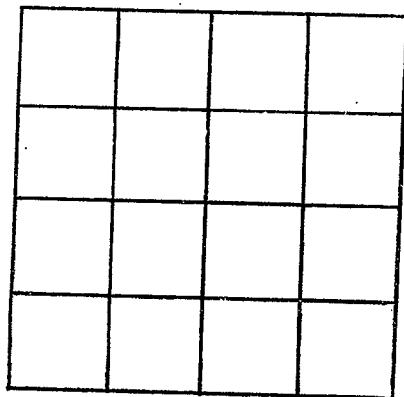

SECTION \_\_\_\_\_

Please indicate well location X.

ADDITIONAL INFORMATION

If more than one screen,  
show locations of each on sketch.