

Madison
 C 2003
 7-9-76

MISSISSIPPI
 BOARD OF WATER COMMISSIONERS
 416 North State Street
 Jackson, Mississippi 39201

WATER WELL DRILLERS LOG

July 9 1976 E.M. "Lud" CRESSWELL Madison
 date well completed firm name county well located

LANDOWNER:
 H. G. Randel
 CANTON, MS.
 (mailing address)

description of formations encountered	from	to
Clay	0	25
Sand	25	89

WELL LOCATION:
 sec 27 T 11 N R 3 E
 10 miles NORTH of CANTON
 (distance) (direction) (nearest town)

WELL PURPOSE: Farm
 (home, irrigation, municipal, industrial)

- WELL COMPLETION DATA:
- (1) diameter (inches) 2
 - (2) total depth (feet) 89
 - (3) static water level (feet) 58 below above top of ground.
 - (4) casing Plastic, 89
 (material) (depth)
2 if telescope see back.
 (size)
 - (5) screen 10, 79
 (length) (depth to top)
2, Plastic
 (size) (material)
 - (6) pump 1, 10
 (HP) (yield gpm)
0
 (type power)
 - (7) electric log no
 (yes or no)
0
 (organization running log)

(8) how well bottom plugged
Steel plug


DRILLERS REMARKS:

RECEIVED
 AUG 3 - 1976

MISS. BD. OF WATER COMMISSIONERS

If well telescopes please
sketch and show depths.

GROUND LEVEL

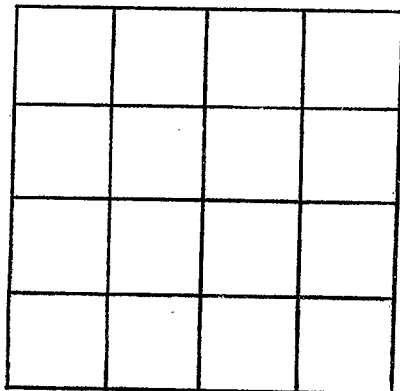

SECTION _____

Please indicate well location X.

ADDITIONAL INFORMATION

If more than one screen,
show locations of each on sketch.