

MADISON
C 2004
7/28/77

MISSISSIPPI
BOARD OF WATER COMMISSIONERS
416 North State Street
Jackson, Mississippi 39201

WATER WELL DRILLERS LOG

July 28 1977 E.M. Bud Cresswell MADISON
date well completed firm name county well located


LANDOWNER:	description of formations encountered	from	to
W B Patterson CANTON, Ms. (mailing address)			
WELL LOCATION:			
sec. 26 T 11 N R 3 E 10 miles North of CANTON (distance) (direction) (nearest town)			
WELL PURPOSE: FARM (home, irrigation, municipal, industrial)			
WELL COMPLETION DATA:			
(1) diameter (inches) 4			
(2) total depth (feet) 470			
(3) static water level (feet) 100 below top of ground.			
(4) casing PVC 430 (material) (depth)			
4 If telescope see back. (size)			
(5) screen 20 430 (length) (depth to top)			
2 STAINLESS (size) (material)			
(6) pump 1 25 (HP) (yield gpm)			
0 (type power)			
(7) electric log no (yes or no)			
0 (organization running log)			
(8) how well bottom plugged Steel plug			
DRILLERS REMARKS:			

RECEIVED
AUG 12 1977

MISS. BD. OF WATER COMMISSIONERS

If well telescopes please
sketch and show depths.

GROUND LEVEL

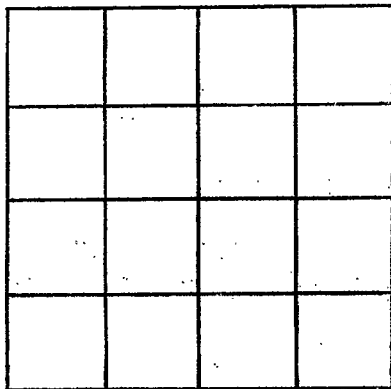

SECTION _____

Please indicate well location X.

ADDITIONAL INFORMATION

If more than one screen,
show locations of each on sketch.