

Randolph Brown CODED

CODED

MISSISSIPPI
BOARD OF WATER COMMISSIONERS
416 North State Street
Jackson, Mississippi 39201

WATER WELL DRILLERS LOG

Madison

Madison
D 21
1-16-69

1-16-69 date well completed
R. S. G. Drillers firm name
Madison county well located

LANDOWNER: Randolph Brown
R. F. & I. Back 88
Carbon Miss
(mailing address)

description of formations encountered	from	to
<u>Red Clay</u>	<u>0</u>	<u>15</u>
<u>white sand and siltstone</u>	<u>15</u>	<u>40</u>
<u>gray sand</u>	<u>40</u>	<u>82</u>

WELL LOCATION:
sec 35 T 11 N R 4 E
S W
2 miles S of Carbon
(distance) (direction) (nearest town)

WELL PURPOSE: Home
(home, irrigation, municipal, industrial)

- WELL COMPLETION DATA:
- (1) diameter (inches) 4 1/2
 - (2) total depth (feet) 82
 - (3) static water level (feet) 55 below above top of ground.
 - (4) casing 9 in 7 1/2
(material) (depth)
 - 3 in if telescope see back.
(size)
 - (5) screen (length) (depth to top)
7
(size) Carbon
(material)
 - (6) pump (HP) (yield gpm)
(type power)
 - (7) electric log (yes or no)
(organization running log)
 - (8) how well bottom plugged

CODED


DATE 21 1969

MISS. DD. OF WATER COMMISSIONERS

DRILLERS REMARKS:

If well telescopes please sketch and show depths.

GROUND LEVEL

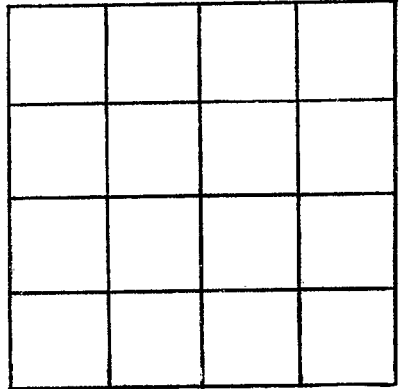

SECTION 35

Please indicate well location X.

ADDITIONAL INFORMATION

If more than one screen,
show locations of each on sketch.