

CODED

APR 28 1969

Madison  
D 23  
4-22-69

MISSISSIPPI  
BOARD OF WATER COMMISSIONERS  
416 North State Street  
Jackson, Mississippi 39201

MISS. BD. OF  
WATER COMMISSIONERS

CODED

WATER WELL DRILLERS LOG

4-22-1969 S. S. Driller Madison county well located

LANDOWNER: prop. J. Curry

description of formations encountered

from to

Rant-to-Bark  
Camden Mill  
(mailing address)

Red clay  
Red sand  
gray and brown  
white sand

0 10  
10 25  
25 50  
40 67

WELL LOCATION:

sec 36 T 4 N R 4 E Camden  
S W  
3 miles South of Camden  
(distance) (direction) (nearest town)

WELL PURPOSE: Home  
(home, irrigation, municipal, industrial)

WELL COMPLETION DATA:

(1) diameter (inches) 4 1/2 hole

(2) total depth (feet) 67

(3) static water level (feet) 35 below above top of ground.

(4) casing 2 1/2 hole 13  
(material) (depth)

(size) if telescope see back.

(5) screen 2 1/4 63  
(length) (depth to top)

2 1/4 blasted pipe  
(size) (material)

(6) pump 2 1/2  
(HP) (yield gpm)

Electric  
(type power)

(7) electric log (yes or no)

(organization running log)

(8) how well bottom plugged 1/4 Plug

DRILLERS REMARKS:


MISS. BD. OF  
WATER COMMISSIONERS

APR 28 1969

MISS. BD. OF  
WATER COMMISSIONERS

If well telescopes please sketch and show depths.

GROUND LEVEL

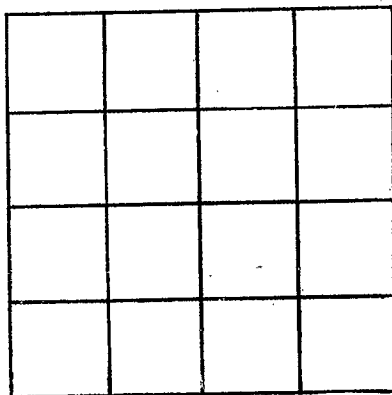

SECTION 36

Please indicate well location X.

ADDITIONAL INFORMATION

If more than one screen, show locations of each on sketch.