

MADISON Miss.

D25

# WATER WELL DRILLERS LOG

# CODED

7-1-66

Date July 1, 1966, Driller: M. KAY

County MADISON

(1) Owner of Land: W.A. DUNCAN  
(Name)

CAMDEN MISS  
(Address)

(2) Location: 1/4, 1/4, Sec. 13 T. 11 R. 9 E.

4 miles N, of CAMDEN  
(distance) (direction) (Nearest Town)

(3) Topography:  (Hilly)  (Flat)  (Level)

(4) Purpose of Well: HOME  
(Domestic Irrigation, Municipal, Industrial, Other)

### Information upon completion of well:

(1) Diameter 2 inches.

(2) Total Depth 200 feet.

(3) Water Level 40 feet below top of ground.

(4) Cased to \_\_\_\_\_, Size \_\_\_\_\_

(5) Screen: Size 007, Length 10

(6) Were any formations sealed against pollution?  
\_\_\_\_\_ yes,  no.

If YES depth of formation \_\_\_\_\_


Why \_\_\_\_\_

Drillers Remarks: \_\_\_\_\_

Description & Color of Materials Sand, Clay, Red Clay, Shell, etc.	Thick- ness Feet	Depth Feet
<u>RED CLAY</u>	<u>0</u>	<u>21</u>
<u>Clay</u>	<u>21</u>	<u>40</u>
<u>Black clay</u>	<u>40</u>	<u>84</u>
<u>THIN - ROCK CLAY</u>	<u>84</u>	<u>100</u>
<u>BROWN CLAY</u>	<u>100</u>	<u>160</u>
<u>Shale Sand - Shell</u>	<u>160</u>	<u>190</u>
<u>Sand</u>	<u>190</u>	<u>200</u>

ROD PUMP

# CODED

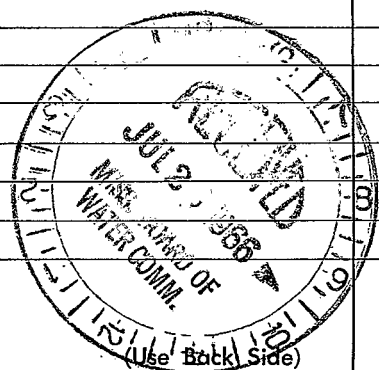

Well No.

000000

10

11

12

13

14

15