

MADISON

D 29

9-19-60

WATER WELL DRILLERS LOG

CODED

Date: Sept 19, 1960, Driller: M^{rs} KAY DRILLING County MADISON
 (Name)

(1) Owner of Land: Johanna White
 (Name)
Cambria Miss.
 (Address)

(2) Location: 28 29 T11 R9E
3 miles W of Cambria
 (distance) (direction) (Nearest Town)

(3) Topography: (Hilly) (Flat) (Level)

(4) Purpose of Well: Home
 (Domestic Irrigation, Municipal, Industrial, Other)

Description & Color of Materials Sand, Clay, Red Clay, Shell, etc.	Thick- ness Feet	Depth Feet
<u>Red Clay</u>	<u>0</u>	<u>21</u>
<u>Rock and Clay</u>	<u>21</u>	<u>42</u>
<u>Blue Clay</u>	<u>42</u>	<u>63</u>
<u>" " "</u>	<u>63</u>	<u>84</u>
<u>" " "</u>	<u>84</u>	<u>105</u>
<u>" " "</u>	<u>105</u>	<u>126</u>
<u>SANDY Clay</u>	<u>126</u>	<u>147</u>
<u>" " "</u>	<u>147</u>	<u>168</u>
<u>MED. SAND BLUE</u>	<u>168</u>	<u>179</u>

Information upon completion of well:

(1) Diameter 2 inches.

(2) Total Depth 179 feet.

(3) Water Level 38 feet below top of ground.


(4) Cased to _____, Size _____

(5) Screen: Size 007X, Length 10

(6) Were any formations sealed against pollution?
 _____ yes, no.

Set Screen
1/2 H.P. ROD Pump
Cylinder 63 ft

CODED

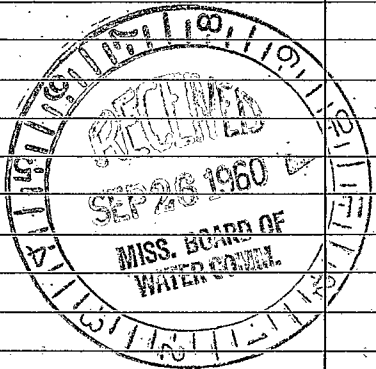

If YES depth of formation _____
 Why _____
 Drillers Remarks: _____

(Use Back Side)

Well No.

1942

1943

1944

1945

1946

1947

1948

[Faint, illegible text covering the majority of the page, possibly bleed-through from the reverse side.]