

Madison
D30
6-68

MISSISSIPPI
BOARD OF WATER COMMISSIONERS
416 North State Street
Jackson, Mississippi 39201

WATER WELL DRILLERS LOG

6/5 1968 John A. Davis Madison
date well completed firm name county well located

LANDOWNER:
J. B. Baird
Camden, Miss
(mailing address)

description of formations encountered	from	to
red clay	0	30
red sand and clay	30	80
white sand	80	155

WELL LOCATION:
sec 32 T 11 N R 4 E
S W
4 miles SW of Camden
(distance) (direction) (nearest town)

WELL PURPOSE: home
(home, irrigation, municipal, industrial)


- WELL COMPLETION DATA:
- (1) diameter (inches) 2¹¹
 - (2) total depth (feet) 155
 - (3) static water level (feet) 50 ^{below} above top of ground.
 - (4) casing Galv 145
(material) (depth)
2" If telescope see-back.
(size)
 - (5) screen 10' 145
(length) (depth to top)
007 6.5
(size) (material)
 - (6) pump 2 12
(HP) (yield gpm)
Elec
(type power)
 - (7) electric log No
(yes or no)
(organization running log)
 - (8) how well bottom plugged Fin

JUL 9 1968
MISSISSIPPI BOARD OF WATER COMMISSIONERS

DRILLERS REMARKS:

If well telescopes please sketch and show depths.

GROUND LEVEL

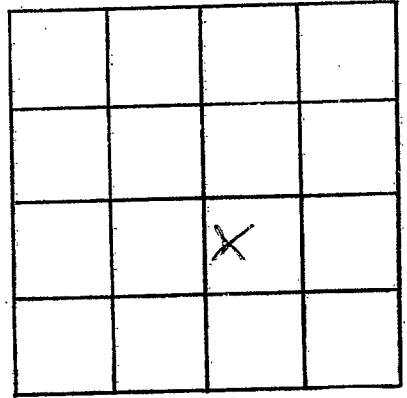

SECTION 32

Please indicate well location X.

ADDITIONAL INFORMATION

If more than one screen,
show locations of each on sketch.